


T. 38S., R. 11 1/2E., W.M.

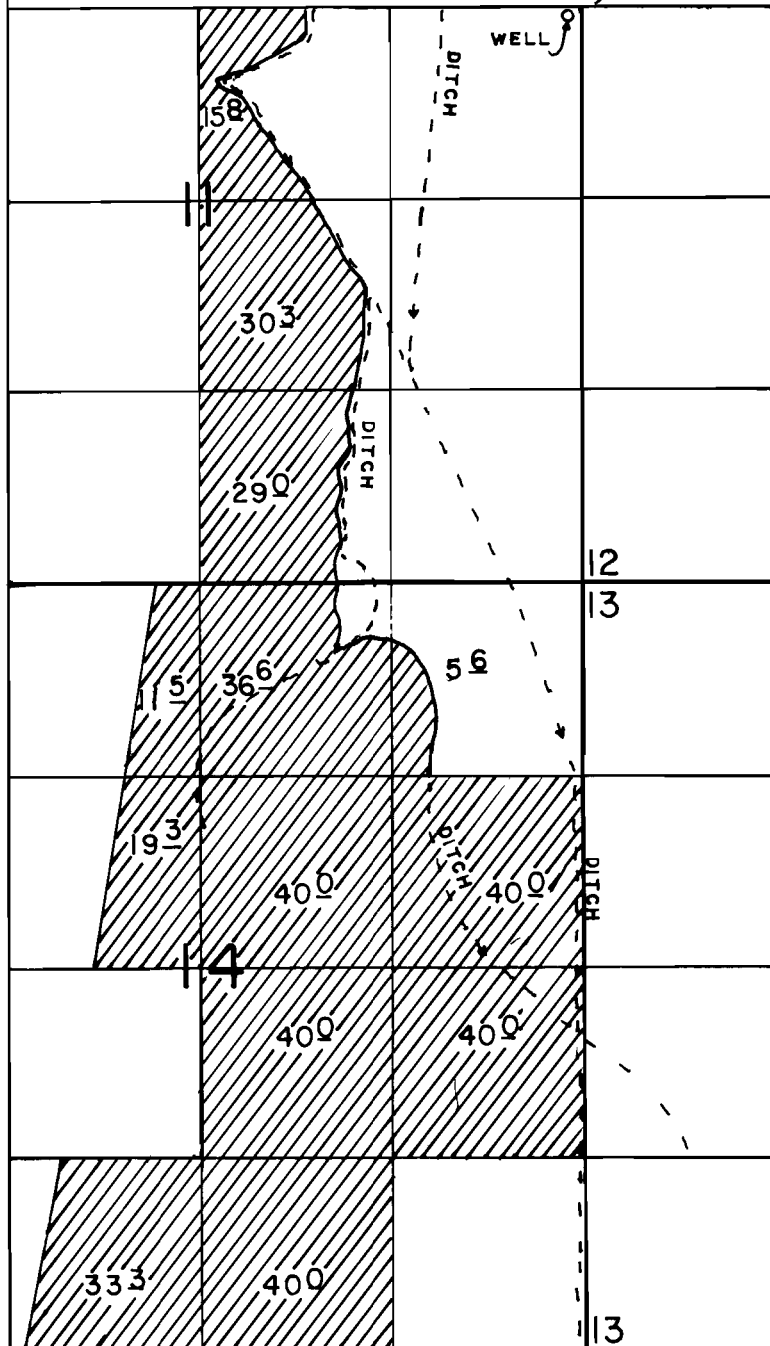

WELL LOC: 1490'S & 70' W FROM NE COR. OF SEC 11.

SCALE: 1"=1320'

FINAL PROOF SURVEY

UNDER

Application No. G-11461 Permit No. G-10567
IN NAME OF

EVERETT W. WALTON

Surveyed MAY 10, 1994, by R.M.SUTTERFIELD

11-13-06 JWG