90684

T. 40 S., R. 14 E., W.M.

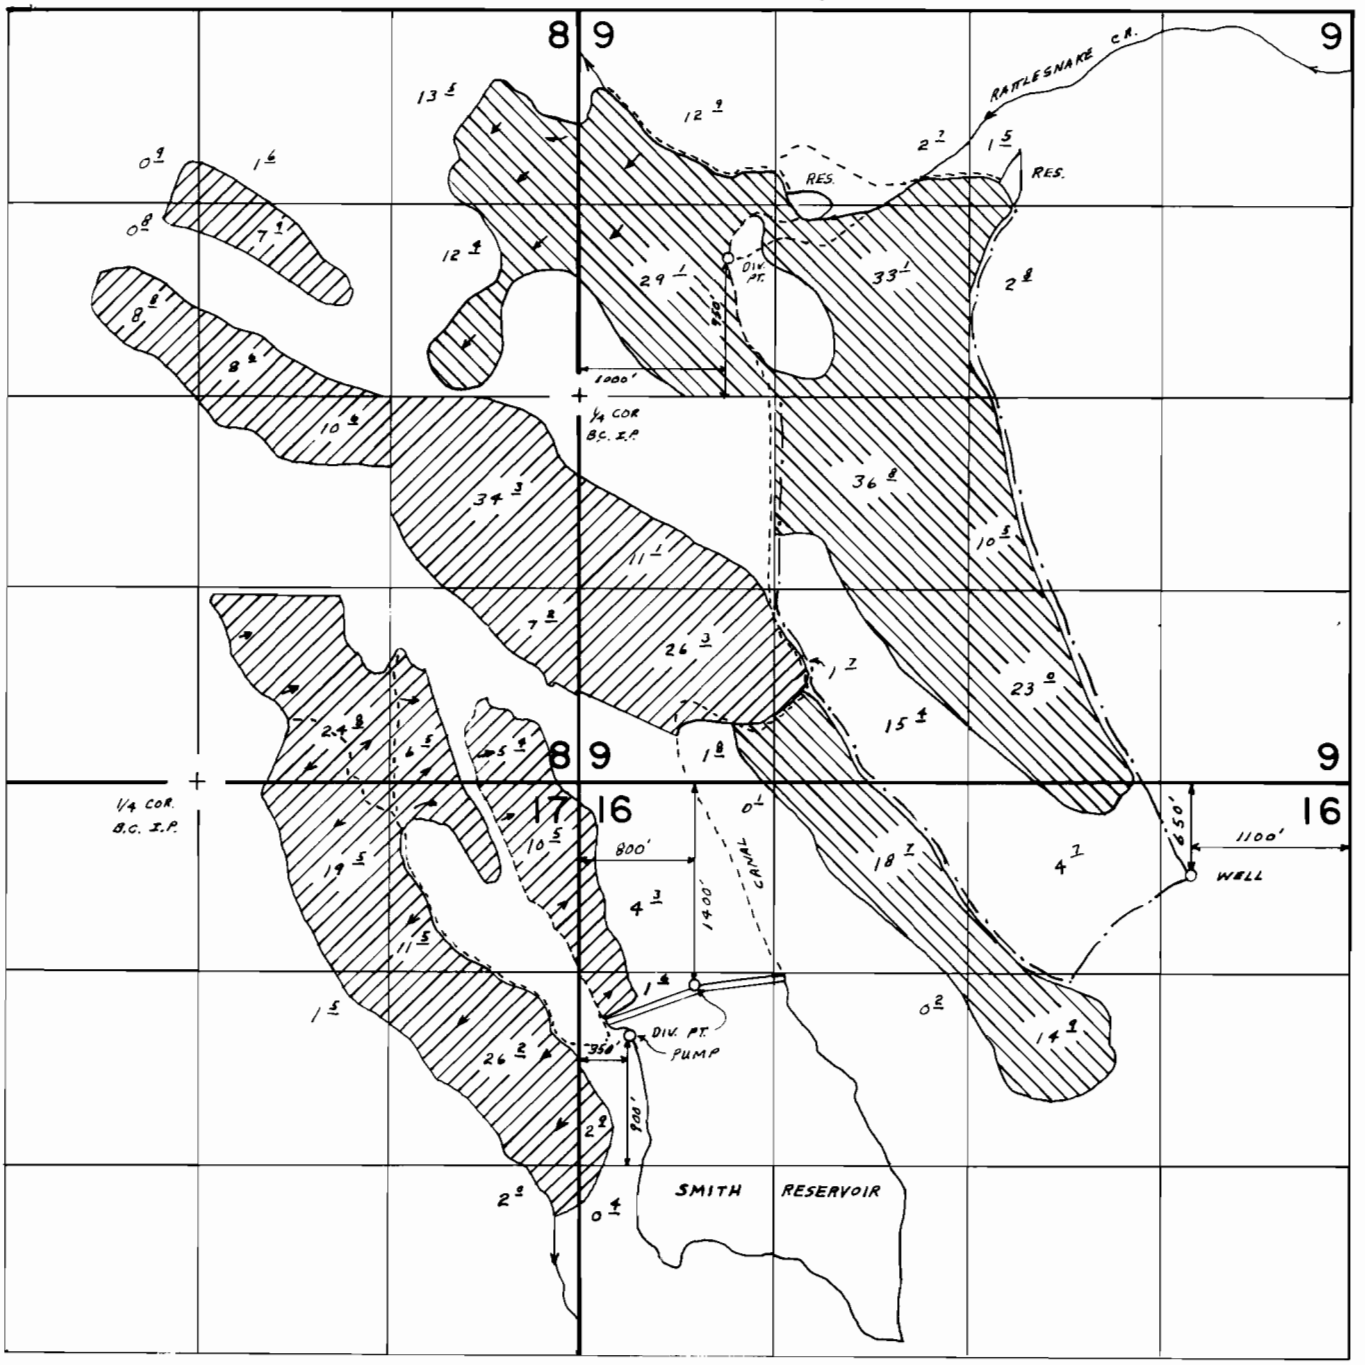

FINAL PROOF SURVEY

UNDER

	G-6198	G-5680
	32892	28984

Application No. R-32891 Permit No. R-3511

IN NAME OF

DOYLE MILLING CO. INC.

Surveyed AUG. 18 1977, by D. NORBY
MAY 24 1988 by B. BISHOP

1-30-89
L.L.C. 1/2

CNO - 4JJ - 158 & 41035-278-53L