


T.40S.,R.8E.,W.M.

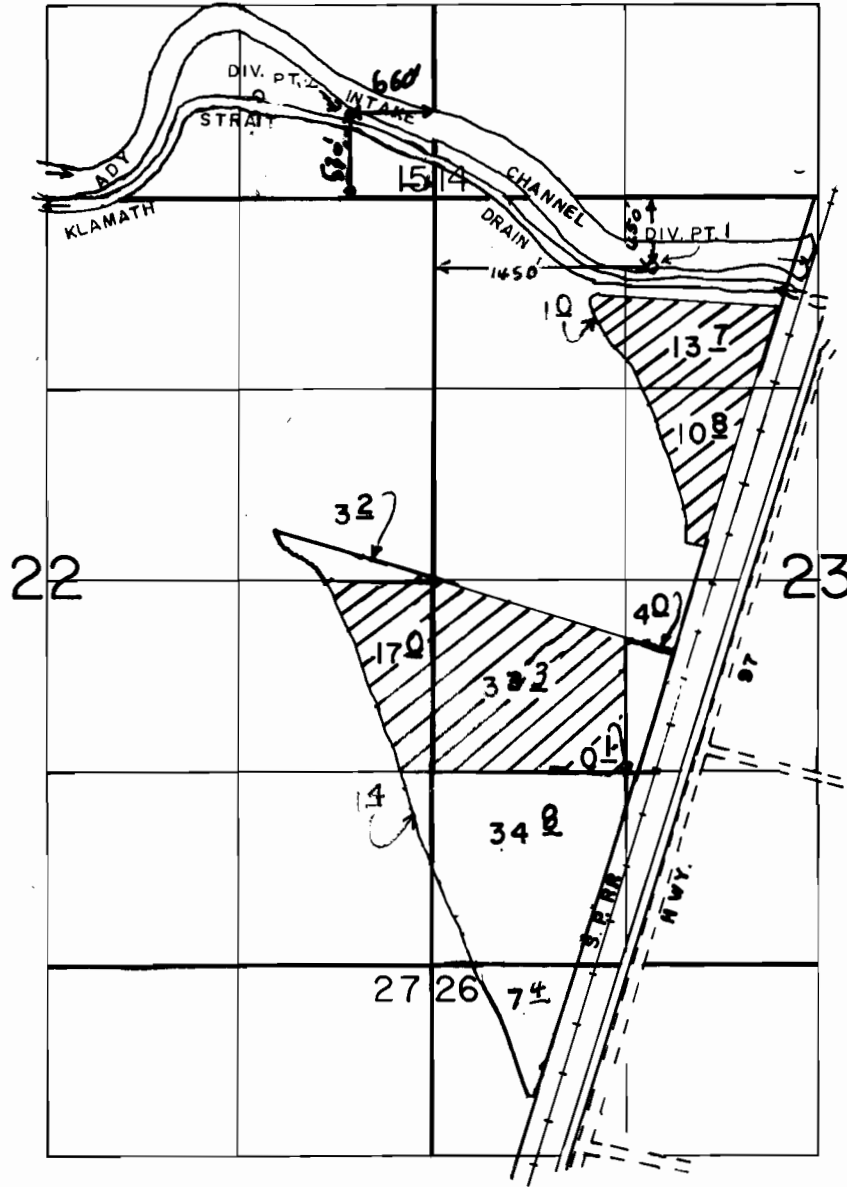

SCALE: 1" = 1320'

**FINAL PROOF SURVEY**  
UNDER

Application No. 63280.. Permit No. 47302.....  
IN NAME OF

..... JAMES A. FLOWERS .....

Surveyed JULY.24 1990, by ...D.SPARKS.....