


T.1 & 2 S. R 17 E., W.M.

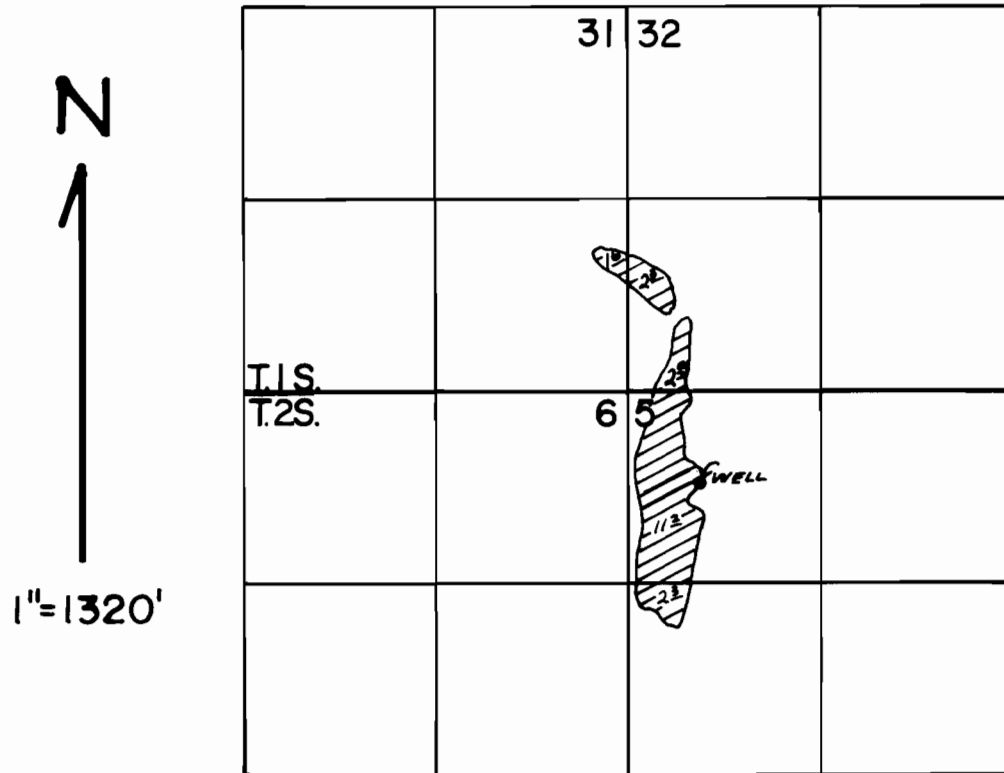

Well located 660 feet South and 495 feet East
from the NW corner of Section 5, T 2 S. R 17 E., W.M.

FINAL PROOF SURVEY UNDER

Application No. G-10038 Permit No. G.10052....
IN NAME OF

-97 RANCH (C. OELSCH, SPENCER).....

Surveyed 10-8.... 1991, by J. MILLER.....