


T. 2 S., R. 26 E., W.M.

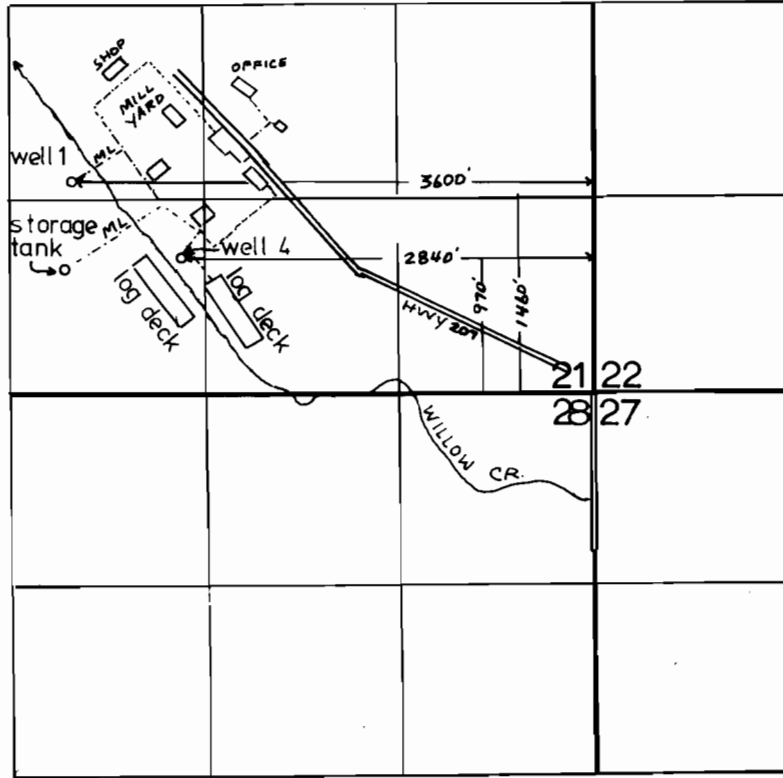

FINAL PROOF SURVEY

UNDER

Application No. G-11233 Permit No. G-10312
IN NAME OF

KINZUA CORPORATION

Surveyed 11-21, 1991, by J. MILLER