


T. 8 S., R. 22 E., W. M.

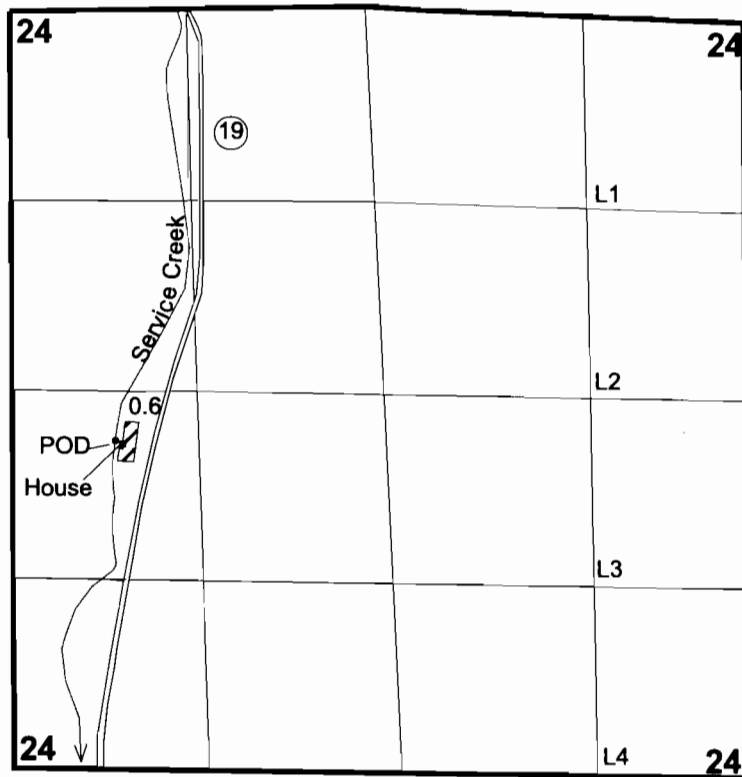

POD - 340 feet South and 712 feet East from the West 1/4 Corner,
Section 24.

FINAL PROOF SURVEY
UNDER

Application NO. 65175 Permit No. 47840

IN THE NAME OF

PHILIP J. SISLER

Surveyed 8-09-2001, by J. Miller