


T. 39S., R. 11E. W.M.

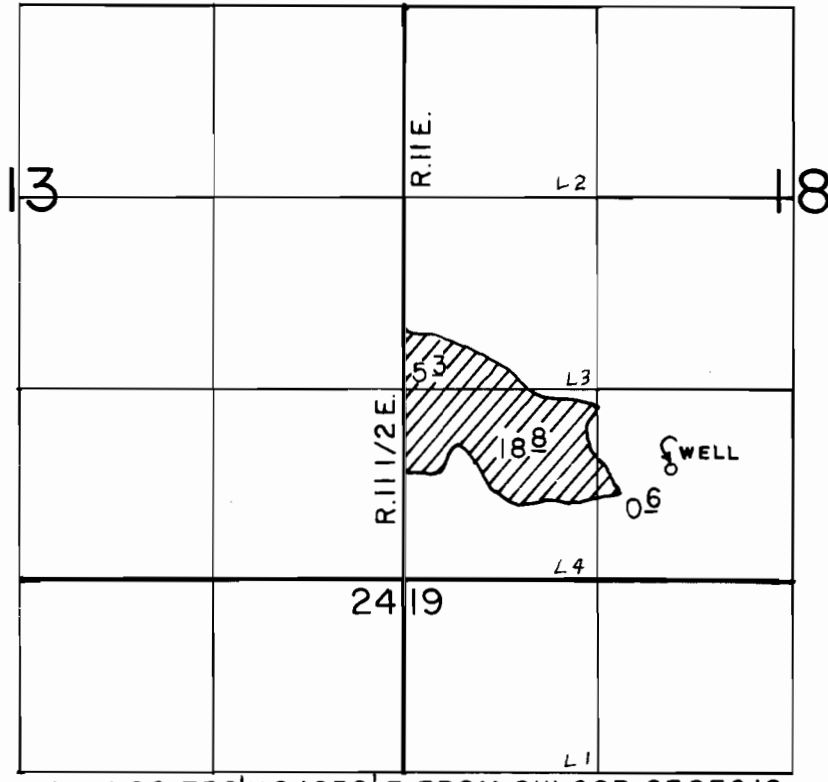

WELL LOC: 750' N & 1830' E FROM SW COR. OF SEC 18.

SCALE: 1" = 1320'

FINAL PROOF SURVEY
UNDER

Application No. G-10447 Permit No. G-9847...
IN NAME OF

.....KENNETH D. MASTEN.....

Surveyed MAY 15, 1991, by R.M. SUTTERFIELD

9/29/06 LHM