


T.3S. R.3E. W. M.

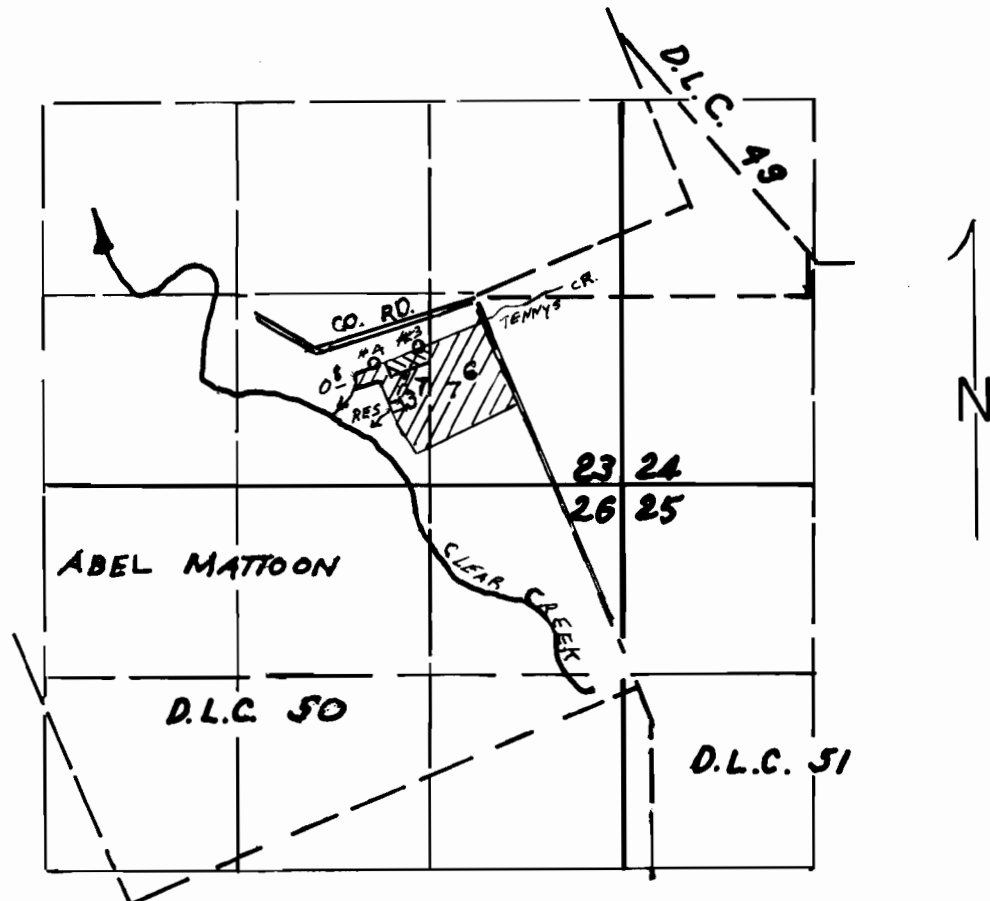

RES. LOCATED 1550' W. & 520' N., DIV. PT. 3 LOCATED 1400' W. & 950' N.,  
 DIV. PT. 4 LOCATED 1600' W. & 520' N., ALL FROM THE S.E. COR. OF SEC. 23

SCALE: 1" = 1320'

# FINAL PROOF SURVEY

UNDER

 SUPPL. RES. ONLY

 SUPPL. RES. & TENNY'S CREEK

R-57629

R-7735

Application No. 57630 Permit No. 43638..

IN NAME OF

CLEAR CREEK NURSERY

Surveyed JULY 23... 1987.., by T.M. WARREN...