


T.3S. R.3E. W. M.

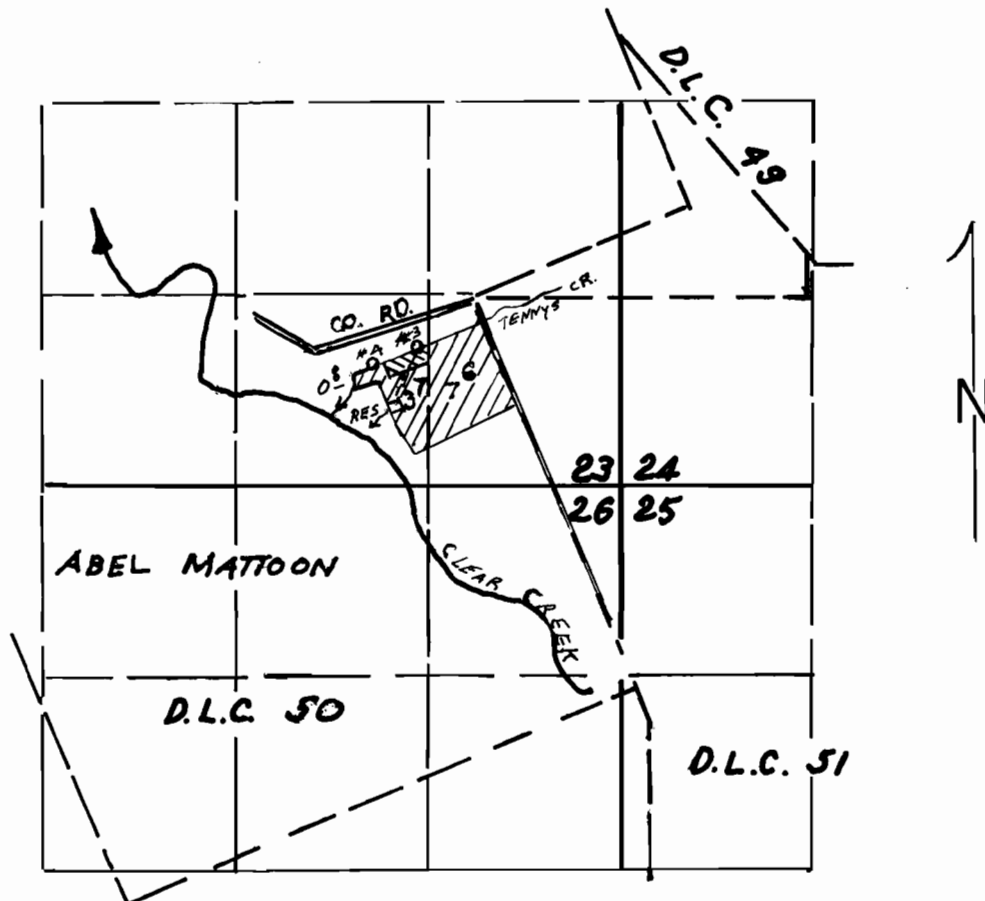

RES. LOCATED 1550' W. & 520' N., DIV. PT. 3 LOCATED 1400' W. & 950' N.,
 DIV. PT. 4 LOCATED 1600' W. & 520' N., ALL FROM THE S.E. COR. OF SEC. 23

SCALE: 1" = 1320'

FINAL PROOF SURVEY

UNDER



SUPPL. RES. ONLY



SUPPL. RES. & TENNYS CREEK

R-57629 R-7735
 Application No. 57630 Permit No. 43638...
 IN NAME OF

...CLEAR CREEK NURSERY...

Surveyed JULY 23... 1987... by T.M. WARREN...