


T. 40 & 41 S., R. 20 E., W.M.

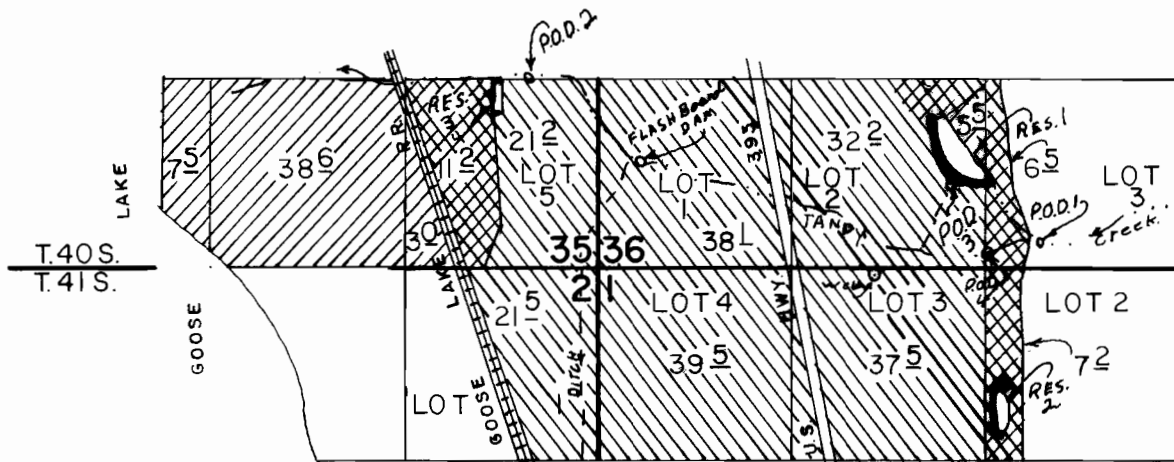

WELL LOC: 75'S & 1900'E FROM NW COR. OF SEC. 1. T. 41 S.
 P.O.D. LOC: 180' N & 2260' W FROM SE COR. OF SEC 36. T. 40 S.
 P.O.D. LOC: 1320' N & 450' W FROM SE COR. OF SEC 35. T. 40 S.
 P.O.D. LOC: 550' N & 2860' W FROM SE COR. OF SEC 36. T. 40 S.
 P.O.D. LOC: 100' N & 2650' W FROM SE COR. OF SEC 36. T. 40 S.
 ALL IN RANGE 20., W.M.

G-10284

SE 32.4 - sec 35
 SW 38.1 - sec 36
 SE 37.7 - sec 36
 SW 6.5 - sec 36

40 > 20

SCALE: 1" = 1320'

NW 7.2 - sec 1
 NE 37.5 - sec 1
 NW 39.5 - sec 1
 NE 21.5 - sec 2

FINAL PROOF SURVEY

Application No. 63548 Permit No. 46923
 UNDER G-11198 G-10286
 IN NAME OF R-8477



PRIMARY
 SUPPLEMENTAL

220.4 ac

GEORGE AND MARGARET BENZ

Surveyed NOV 14, 1990, by B.W.BISHOP

220.4 x 1/80 = 2.755 ac

2.76 ac