


T. 40 & 41 S., R. 20 E., W.M.

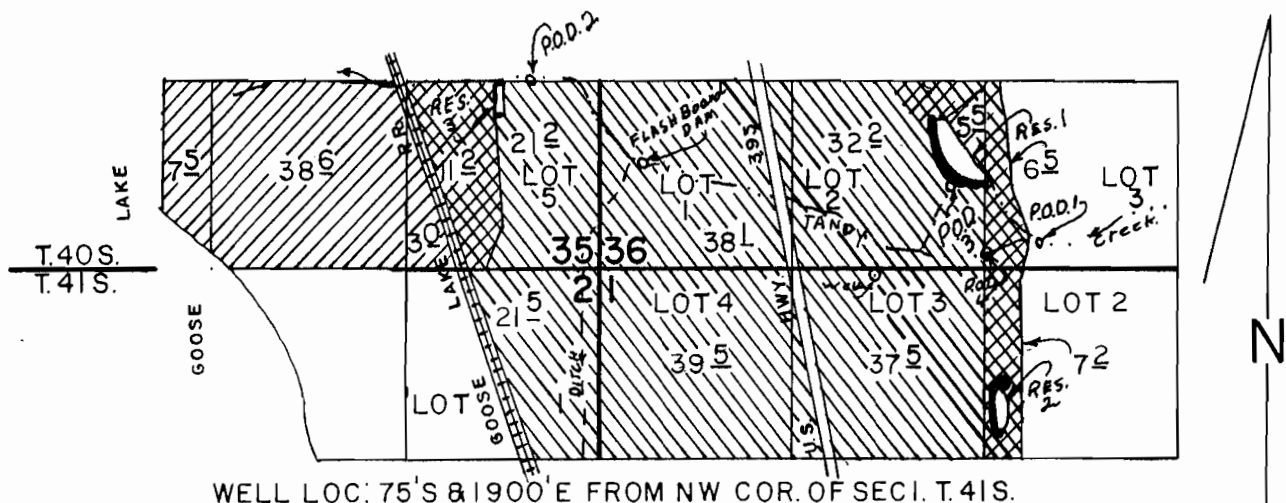

WELL LOC: 75'S & 1900'E FROM NW COR. OF SEC. 1. T. 41 S.
 P.O.D. 1 LOC: 180' N & 2260' W FROM SE COR. OF SEC 36. T. 40 S.
 P.O.D. 2 LOC: 1320' N & 450' W FROM SE COR. OF SEC 35 T. 40 S.
 P.O.D. 3 LOC: 550' N & 2860' W FROM SE COR. OF SEC 36. T. 40 S.
 P.O.D. 4 LOC: 100' N & 2650' W FROM SE COR. OF SEC 36 T. 40 S.
 ALL IN RANGE 20., W.M.

SCALE: 1" = 1320'

FINAL PROOF SURVEY

Application No. 63548 UNDER 46923 PRIMARY
G-11198 Permit No. G-10286 SUPPLEMENTAL
 IN NAME OF R-63191 R-8477

GEORGE AND MARGARET BENZ

Surveyed NOV 14, 1990, by B.W.BISHOP