


T. 5 S., R. 3 W., W.M.

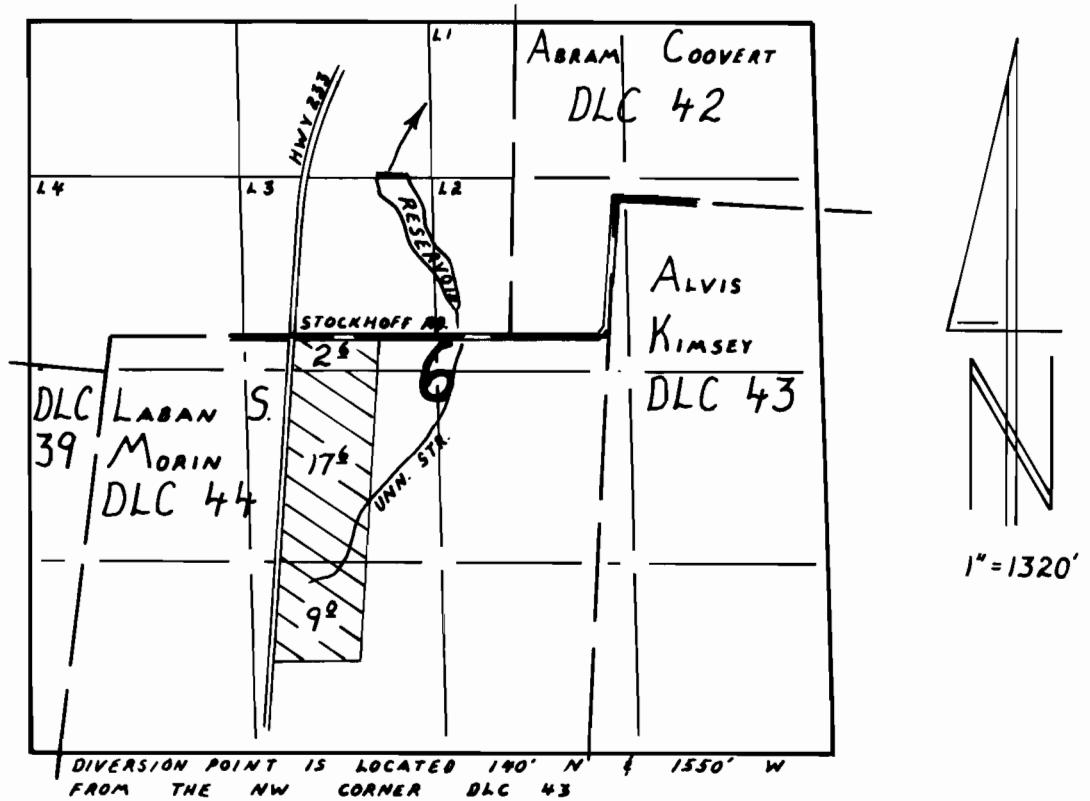

FINAL PROOF SURVEY

UNDER

Application No. 69000 Permit No. 49953

IN NAME OF

MONROVIA NURSERY COMPANY

Surveyed FEBRUARY 26, 1991, by R.W. Klassen