


T. 5 S., R. 3 W., W.M.

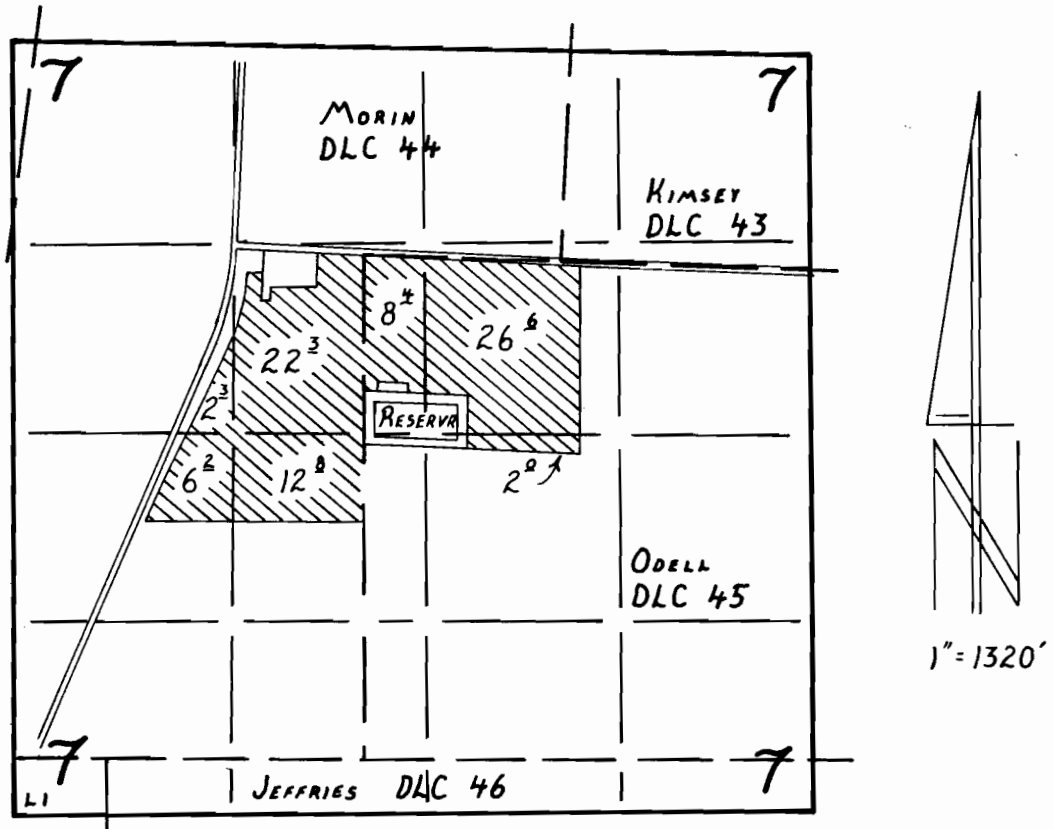

FINAL PROOF SURVEY

UNDER

Application No. R-64612, 64613 Permit No. R-8650, 47497
IN NAME OF

Monrovia Nursery Company

Surveyed August 18, 1988, by Z.F. Saleh