

App # G-12726
Permit # G-11426

T. 6 S. R. 1 W. W.M.


RECEIVED

SEP 22 1991

WATER RESOURCES DEPT.
S.W. OREGON, OREGON



4" = 1 MI.

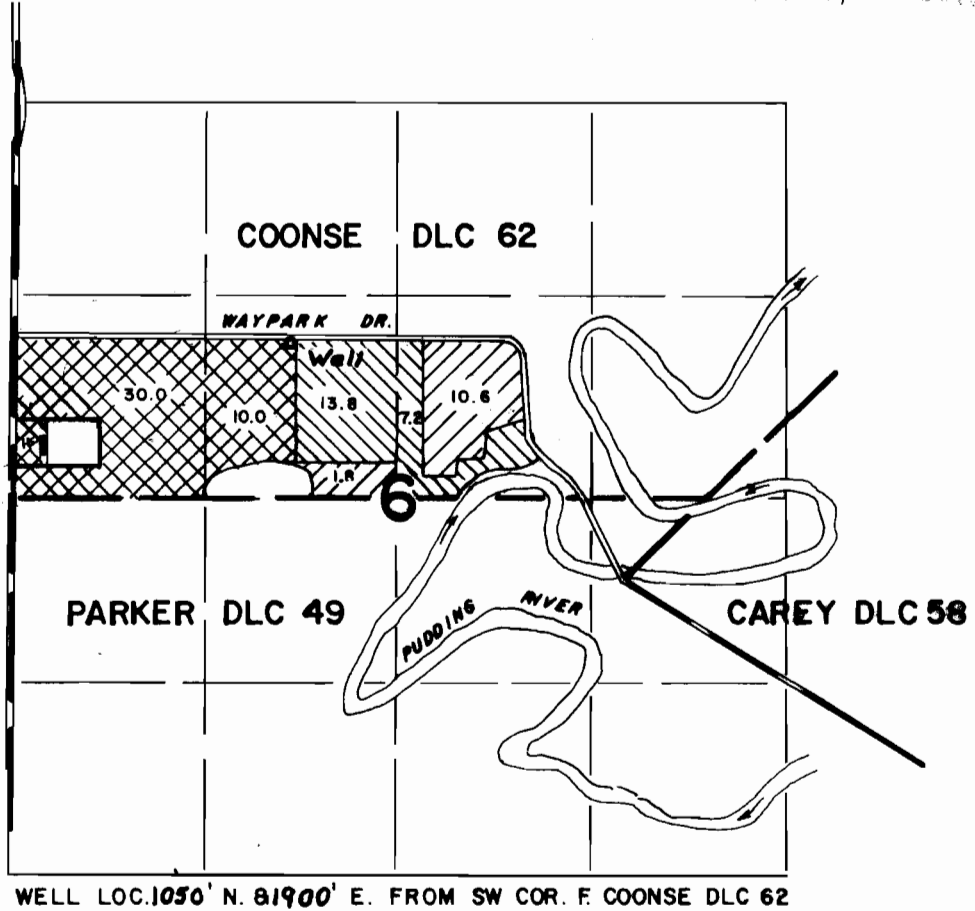

SUPPL. TO GR-1047



PERMIT NO. 16991 (SUPPL.)




PERMIT NO. 40012 (SUPPL.)

FINAL PROOF
WATER RIGHT MAP FOR

PETER MILLER

SURVEYED ON NOV. 15, 1991 & SEPT. 1, 1994

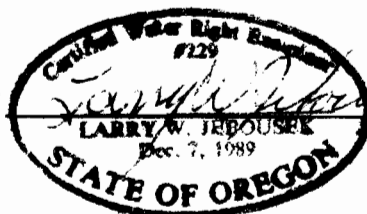

THIS MAP WAS PREPARED FOR THE PURPOSE OF IDENTIFYING THE LOCATION OF A WATER RIGHT ONLY AND IS NOT INTENDED TO PROVIDE LEGAL DIMENSIONS OR LOCATION OF PROPERTY OWNERSHIP LINES.