



T.40S., R.9E., W.M.

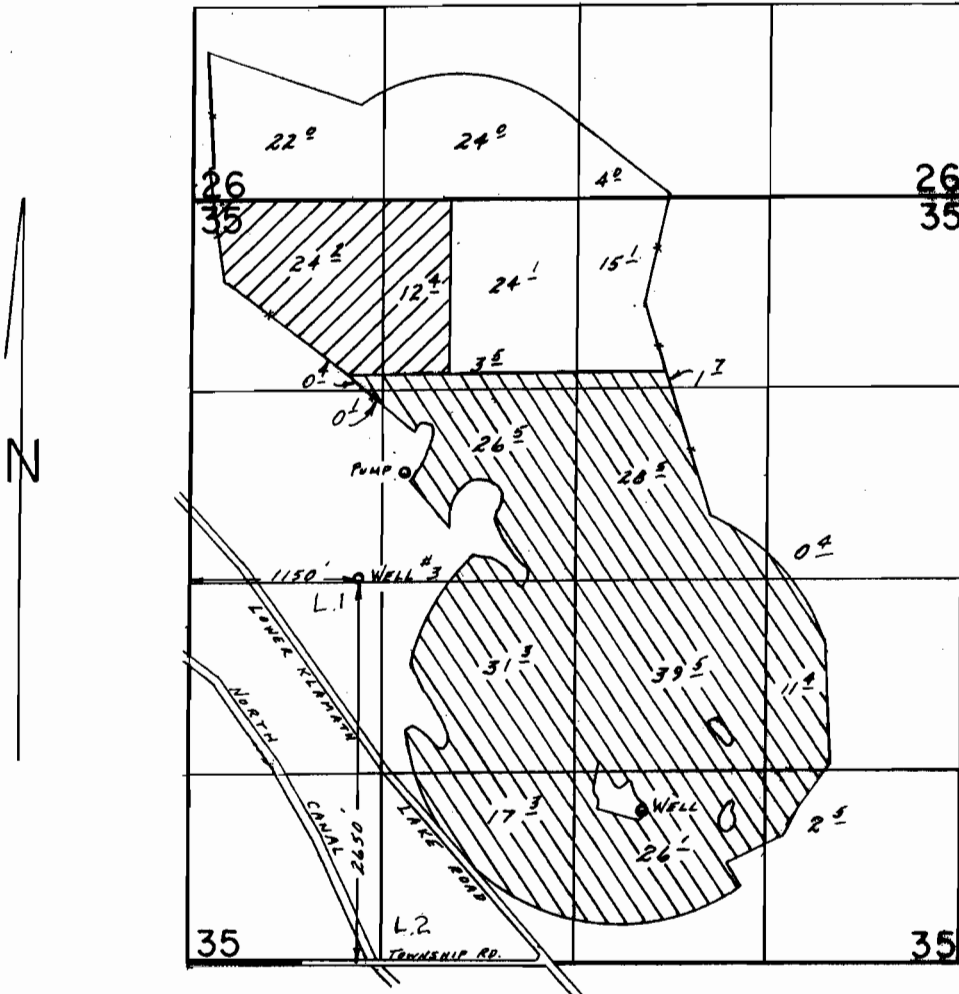

SCALE: 1" = 1320'

FINAL PROOF SURVEY UNDER


G-8730 G-8102
 Application No. G:11206 Permit No. G:10363...  Portion only
 IN NAME OF

.....O'CONNER LIVESTOCK CO.....

Surveyed Oct. 5..... 1988, by B.W. BISHOP.....

LHN 9/28/06
1/30/09

T. 41S., R. 9&10E., W.M.

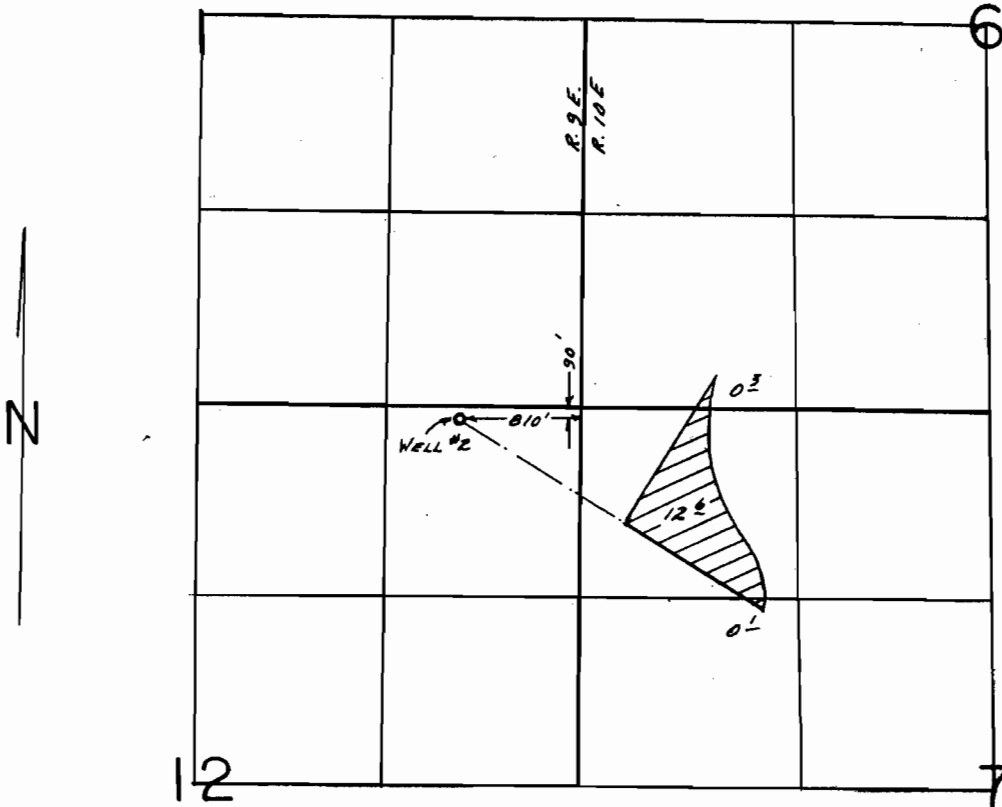

SCALE: 1" = 1320'

FINAL PROOF SURVEY
UNDER

Application No. G:11206. Permit No. G:10363...Portion only
IN NAME OF

.....O'CONNER LIVESTOCK CO.....

Surveyed Oct. 5..... 19.88, by B.W. BISHOP.....

1/30/09
CNO-511-27