



# T.40S., R.9E., W.M.

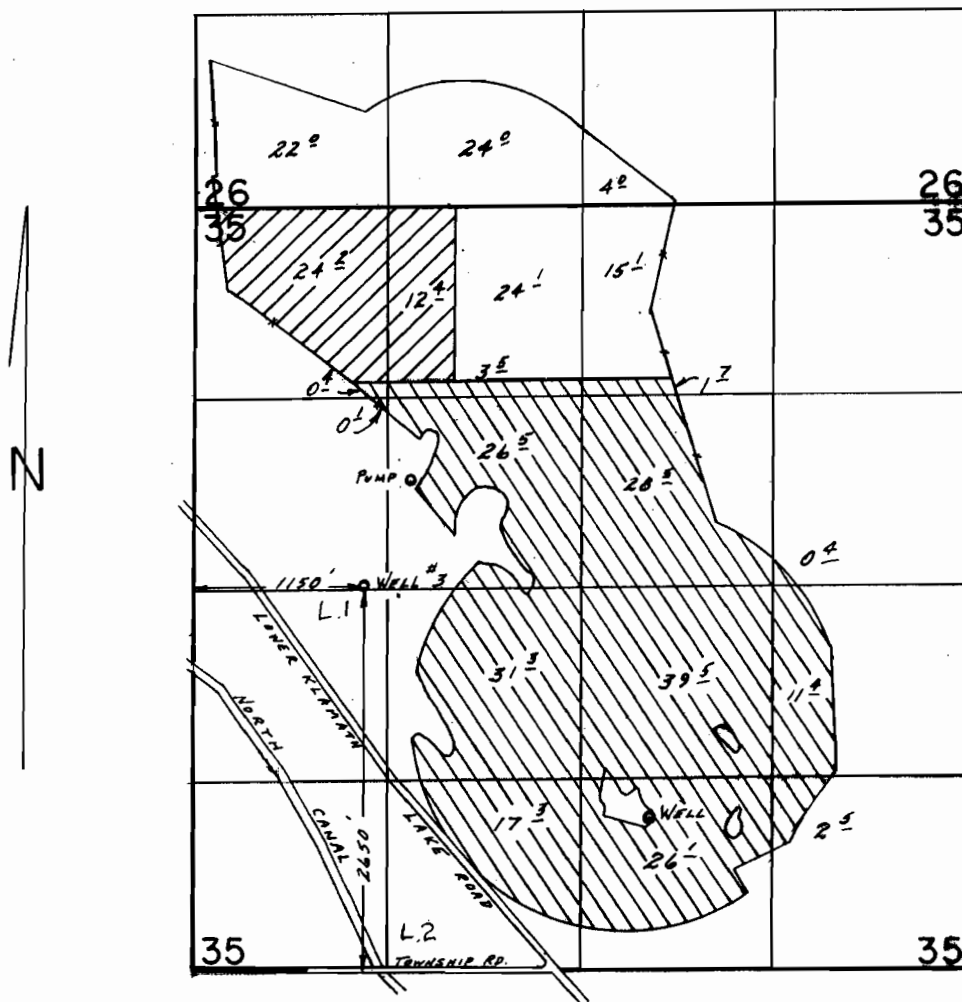

SCALE: 1" = 1320'

## FINAL PROOF SURVEY UNDER

Application No. G-8730      G-8102       Portion only  
 G-11206 Permit No. G-10363...  
 IN NAME OF

.....O'CONNER LIVESTOCK CO.....

Surveyed Oct. 5..... 1988, by B.W. BISHOP.....

LWIN 9/28/06  
1/20/89 RMB