

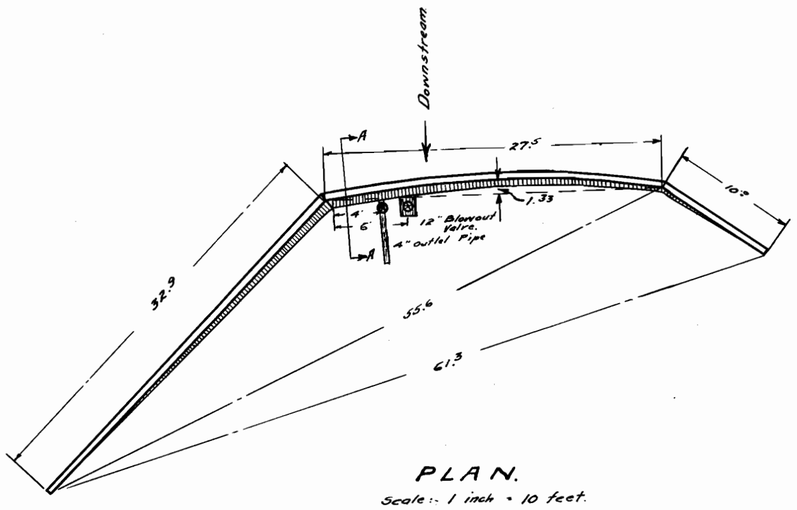



PLAN.
Scale:- 1 inch = 10 feet.

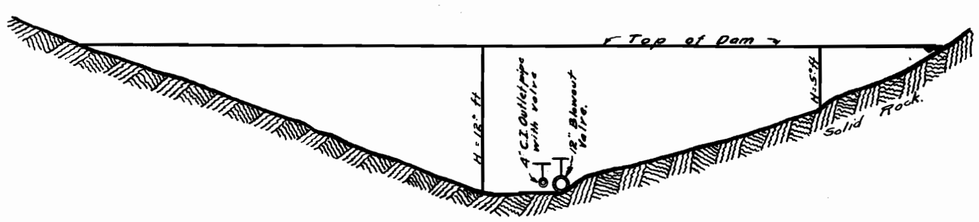



PROFILE.
Scale:- 1 inch = 10 feet.

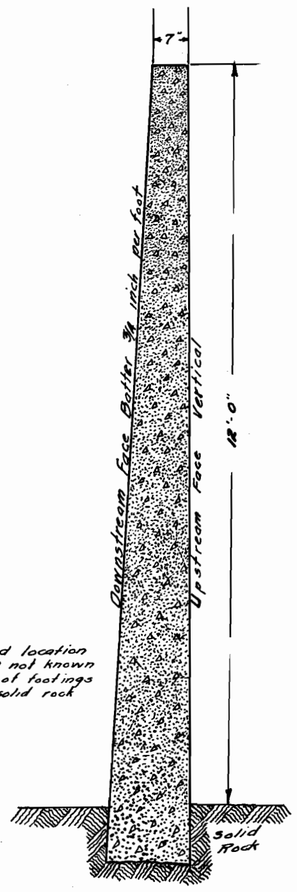


Note:
Quantity and location of reinforcing not known nor is depth of footings below top of solid rock known.

SECTION A-A
Scale:- 1 inch = 2 feet.

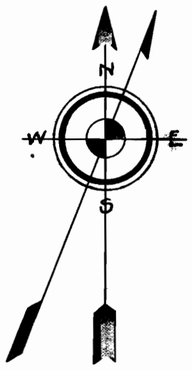





I, C.F. Bessee, of Marshfield, Oregon, do hereby certify that this map was made from notes taken taken during an actual survey made by me on August 13th, 1927, and that it correctly represents the work described in the accompanying application, together with the location of streams in the immediate vicinity.

C. F. Bessee
Registered Professional Engineer.
Oregon No 1286
Date of Registration July 11, 1924.

Scale of Vicinity Map:- 1 inch = 500 feet.

MAP ACCOMPANYING APPLICATION OF
LELA G. SIMPSON
FOR USE OF WATER FROM
4 UN-NAMED CREEKS ON
"SHOREACRES"
SECTIONS 17 AND 18, TWP. 26 S.,
RGE. 14 W., WILLAMETTE MERIDIAN.

REGISTERED PROFESSIONAL ENGINEER
1286
C. F. Bessee.
OREGON
JULY 11, 1924
C. F. BESSEE

Application No. 11787
Permit No. 8820