


T.6S.,R.4W.,W.M.

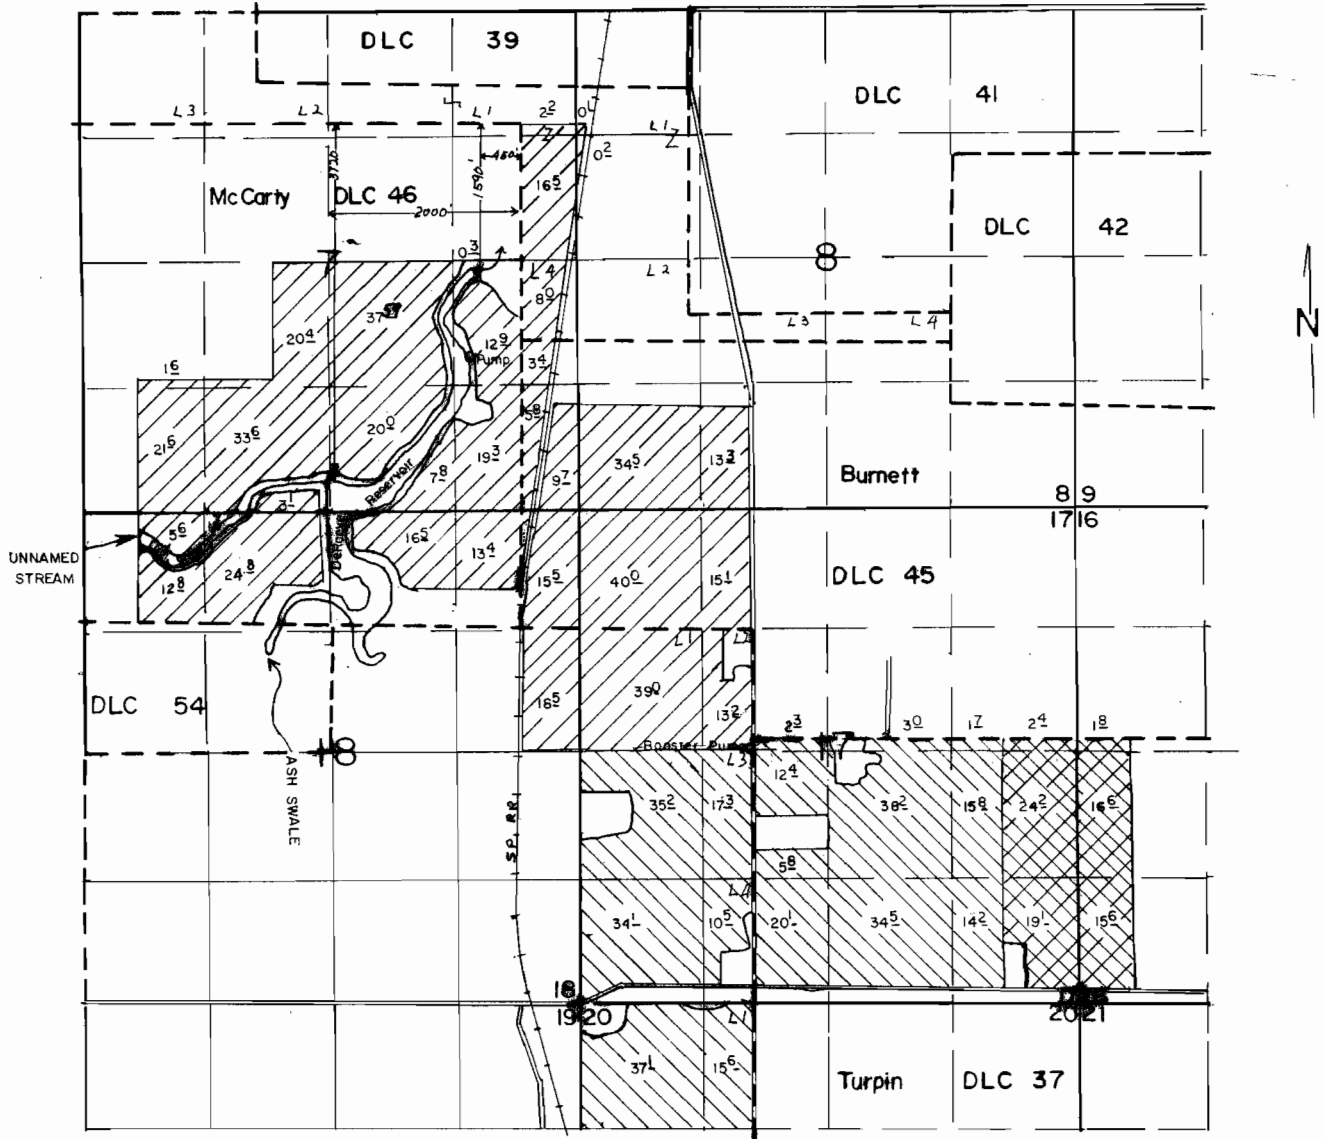

FINAL PROOF SURVEY  
UNDER




R-54226                      R-6487  
54227                        40684  
R-67984                    R-10482  
67985                        49361

Application No. 63809..... Permit No. 46958.....

IN NAME OF

Marvin John & Patricia Ann DeRaeve

Surveyed MAY...18....1999 By J.M. WARREN.....

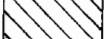	Permit 40684 Primary
	Permit 49361 Supplemental
	Permit 46958 Primary

11-2-06 SWG