


T.6S.,R.4W.,W.M.

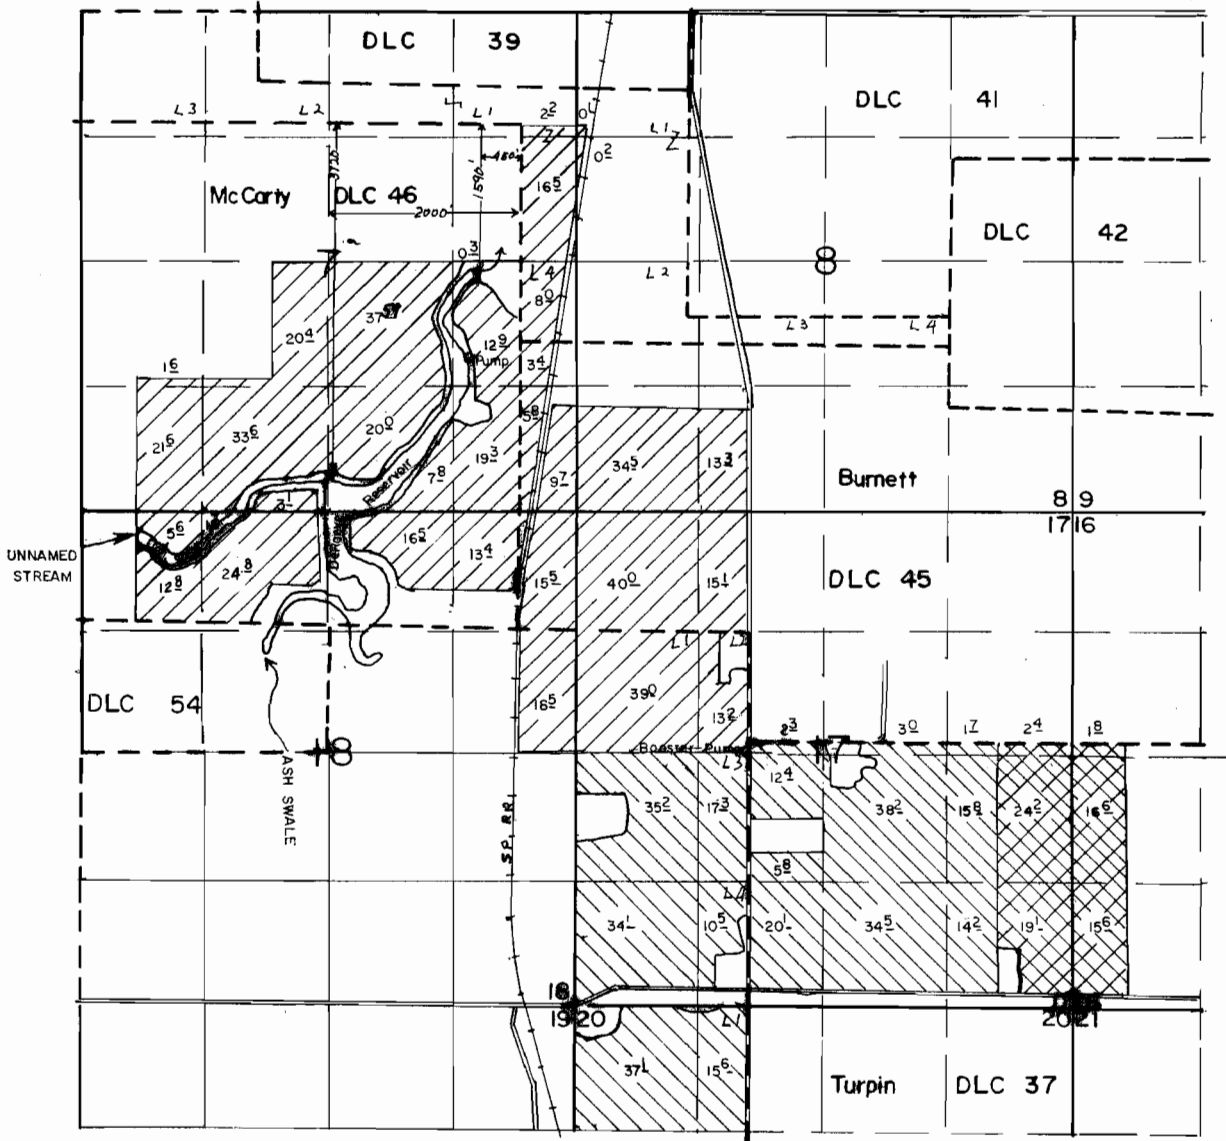

FINAL PROOF SURVEY
UNDER

R-54226 R-6487
 54227 40684
 R-67984 R-10482
 67985 49361

Application No. 63809 Permit No. 46958

IN NAME OF

Marvin John & Patricia Ann DeRaeve

Surveyed MAY 18 1999 By J.M. WARREN

| | |
|--|------------------------------|
| | Permit 40684 Primary |
| | Permit 49361 Supplemental |
| | Permit 46958 Primary |

11-2-06 JWG