


T.6S.,R.4W.,W.M.

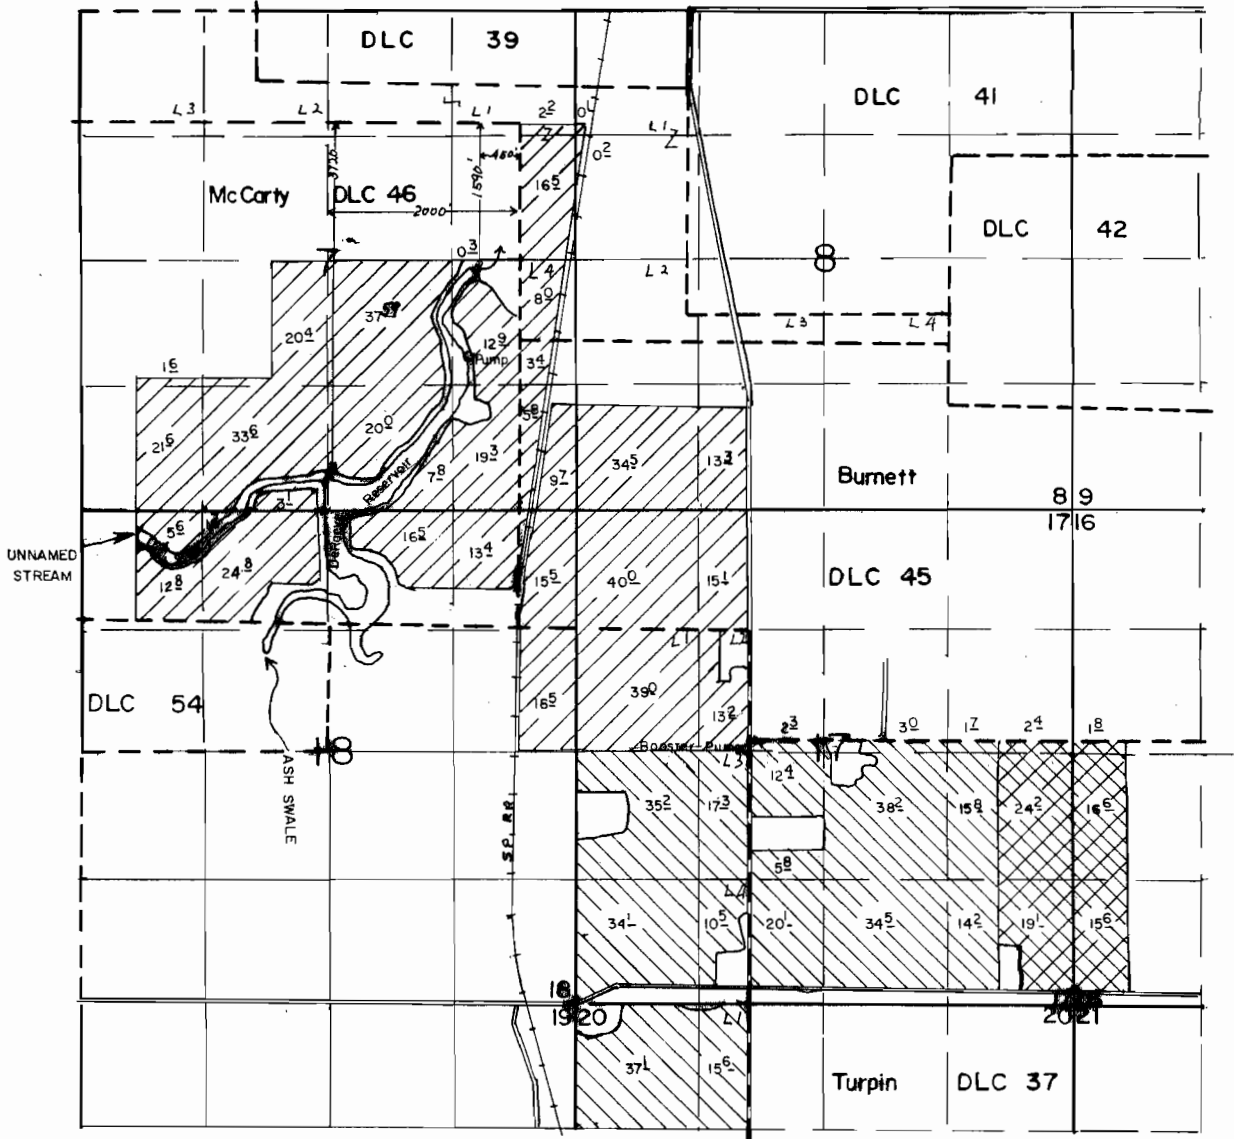

FINAL PROOF SURVEY
UNDER

R-5 4226 R-6487
 54227 40684
 R-67984 R-10482
 67985 49361
 Application No. 63809..... Permit No. 46958.....

IN NAME OF

Marvin John & Patricia Ann DeRaeve

Surveyed MAY 18 1989 By T.M. WARREN

	Permit 40684 Primary
	Permit 49361 Supplemental
	Permit 46958 Primary

11-2-06 SWG