


T. 1 S., R. 2 & 3 W., W.M.

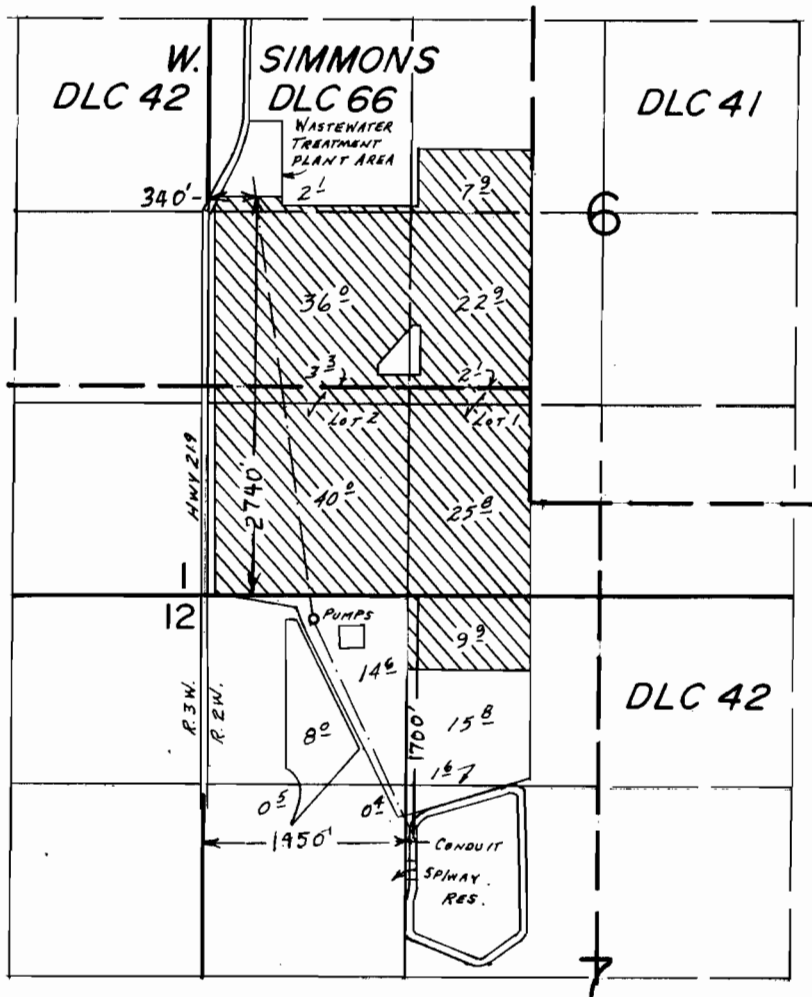

SCALE: 1" = 1320'

FINAL PROOF SURVEY UNDER

R-63317 R-8396
Application No. 63318... Permit No. 46641.....
IN NAME OF

UNIFIED SEWERAGE AGENCY OF WASHINGTON COUNTY

Surveyed Aug. 18, 1986, by B.W. BISHOP.....

12/12/06
LHN
1/12/07
BWB

41067-178-140B
PTS 1986B