


T. 34 S., R. 9 E., W.M.

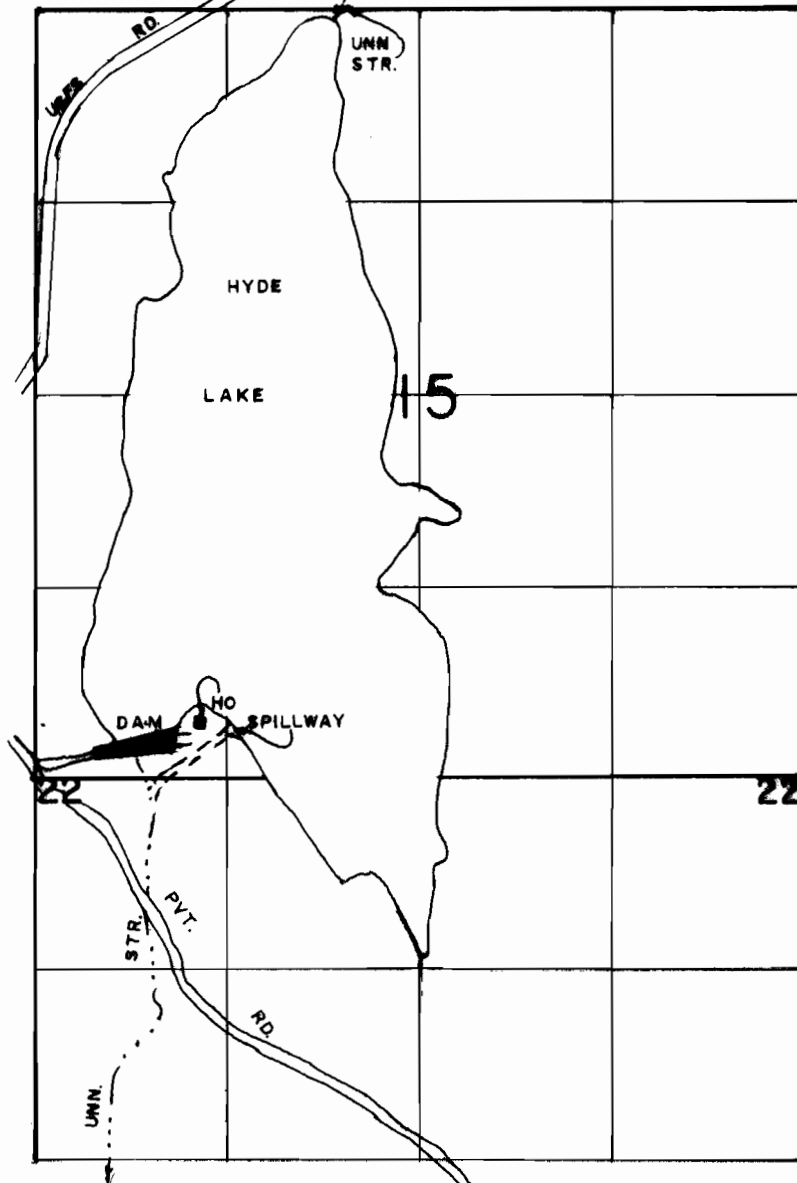

POD LOCATED: 200' N & 700' E FROM SW COR. SEC. 15

SCALE: 1" = 1320'

FINAL PROOF SURVEY

48533 UNDER
R-47974

35693
R-5753
34798

Application No. R-43768 Permit No. R-5557
IN NAME OF

DAYTON O. & GERDA V. HYDE

Surveyed JULY 12, 1994, by R.M.SUTTERFIELD