


**T. 34 S., R. 9 E., W.M.**

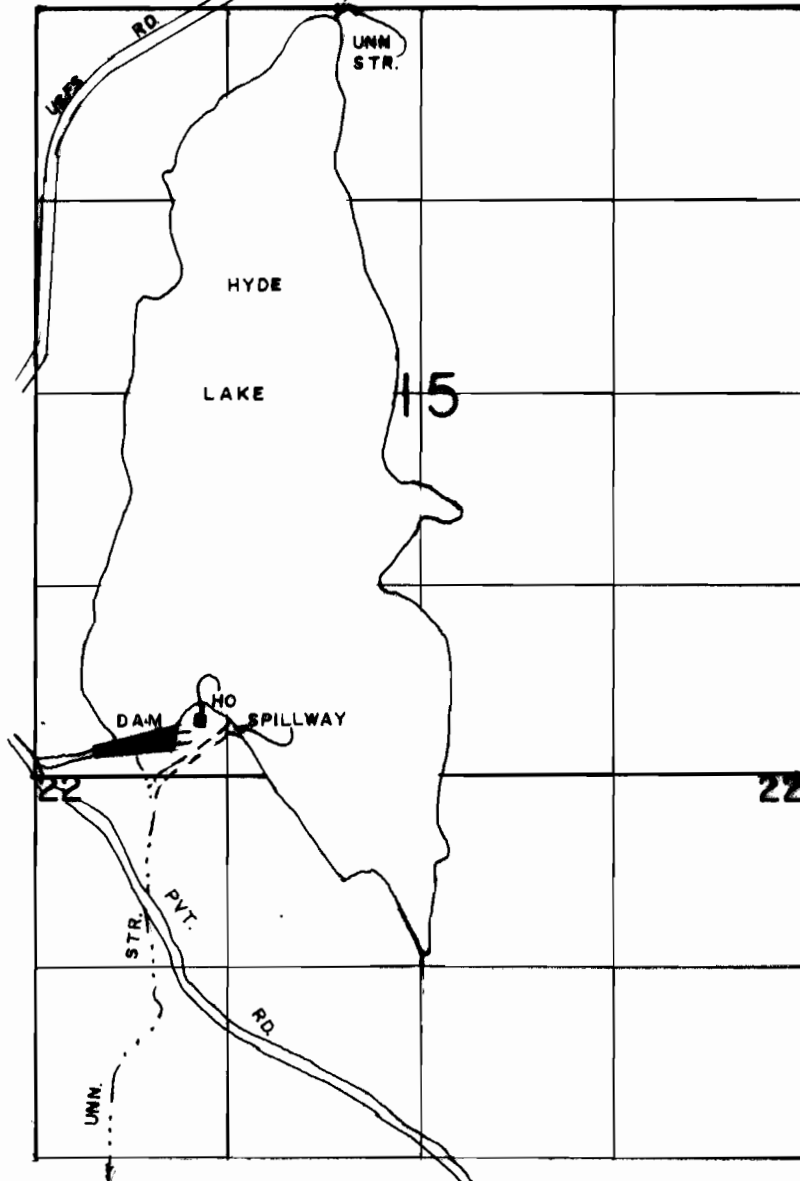

POD LOCATED: 200' N & 700' E FROM SW COR. SEC. 15

SCALE: 1" = 1320'

**FINAL PROOF SURVEY**

48533 UNDER  
R-4797

35693  
R-5753  
34798

Application No. R-43768 Permit No. R-5557  
IN NAME OF

**DAYTON O. & GERDA V. HYDE**

Surveyed JULY 12, 1994, by R.M. SUTTERFIELD