


T. 1 S., R. 2 W., W.M.

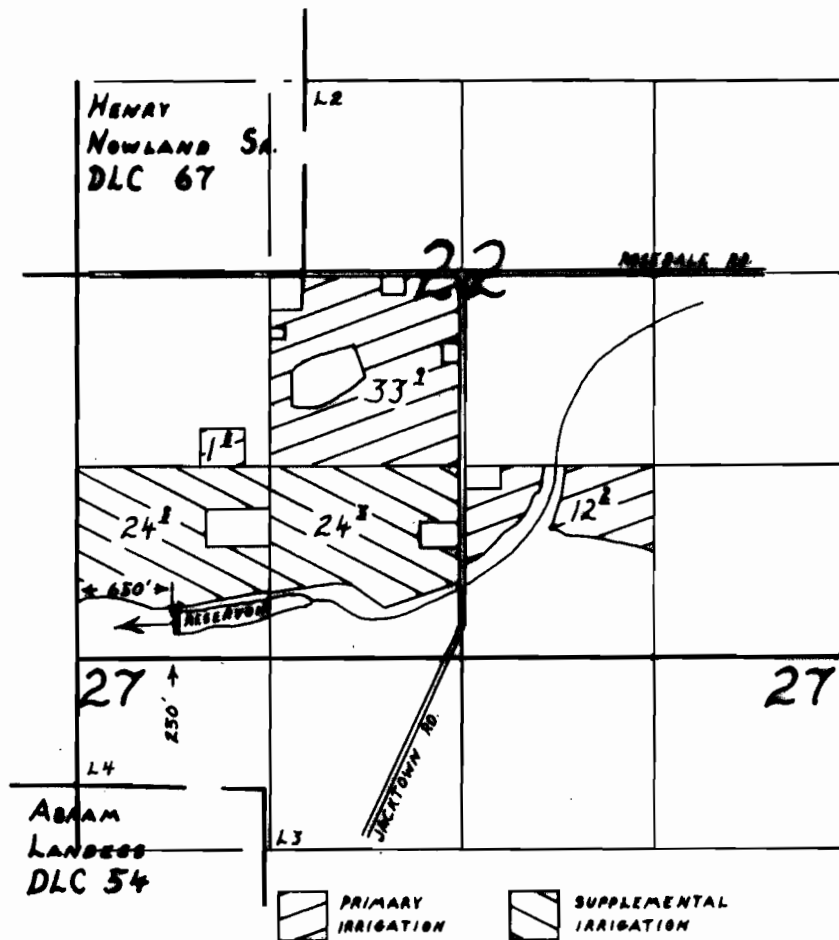

FINAL PROOF SURVEY

UNDER

Application No. R-69168 & 69169 Permit No. R-11224 & 50969
IN NAME OF

ELDON L. & RONALD E. WILLIAMSON

Surveyed April 27, 1994, by R.W. Klassen