
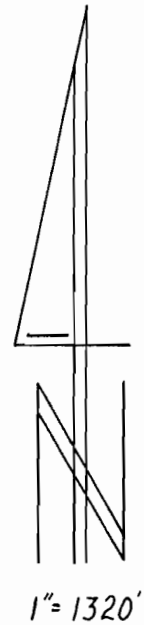


T. 8 S., R. 3 W., W.M.

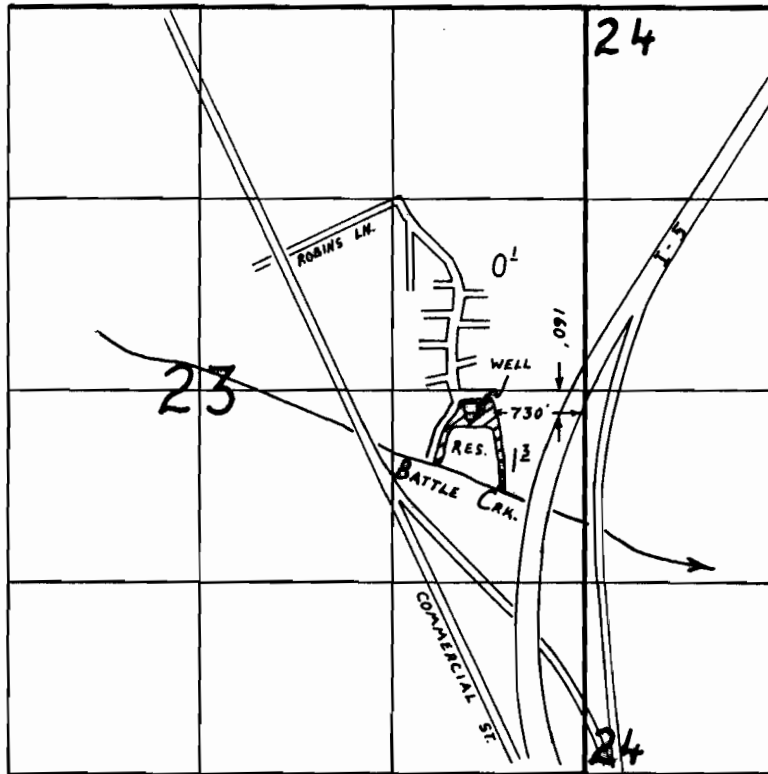

FINAL PROOF SURVEY

UNDER

Application No. G-9103 R-50231, 50240 Permit No. G-8792 R-8098, 44724
IN NAME OF

TERRACE LAKE

Surveyed AUGUST 17, 1992, by R.W. Klassen