

TOWNSHIP 13 SOUTH, RANGE 24 EAST, W.M.

RECEIVED

APR 03 2003

WATER RESOURCES DEPT.
SALEM, OREGON

FINAL PROOF SURVEY UNDER


Application No. R-88815 Permit No. R-10788
68816 48763
R-88200 R-10035
68201 48987

IN THE NAMES OF
CLINTON O. HARRIS
AND
FLORA H. HARRIS
OF
ANTONE RANCH



Surveyed: July 17, 2002 by: J. Miller



1" = 1320'

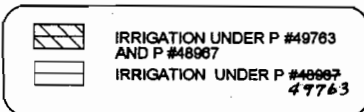

POD - FROG POND RESERVOIR

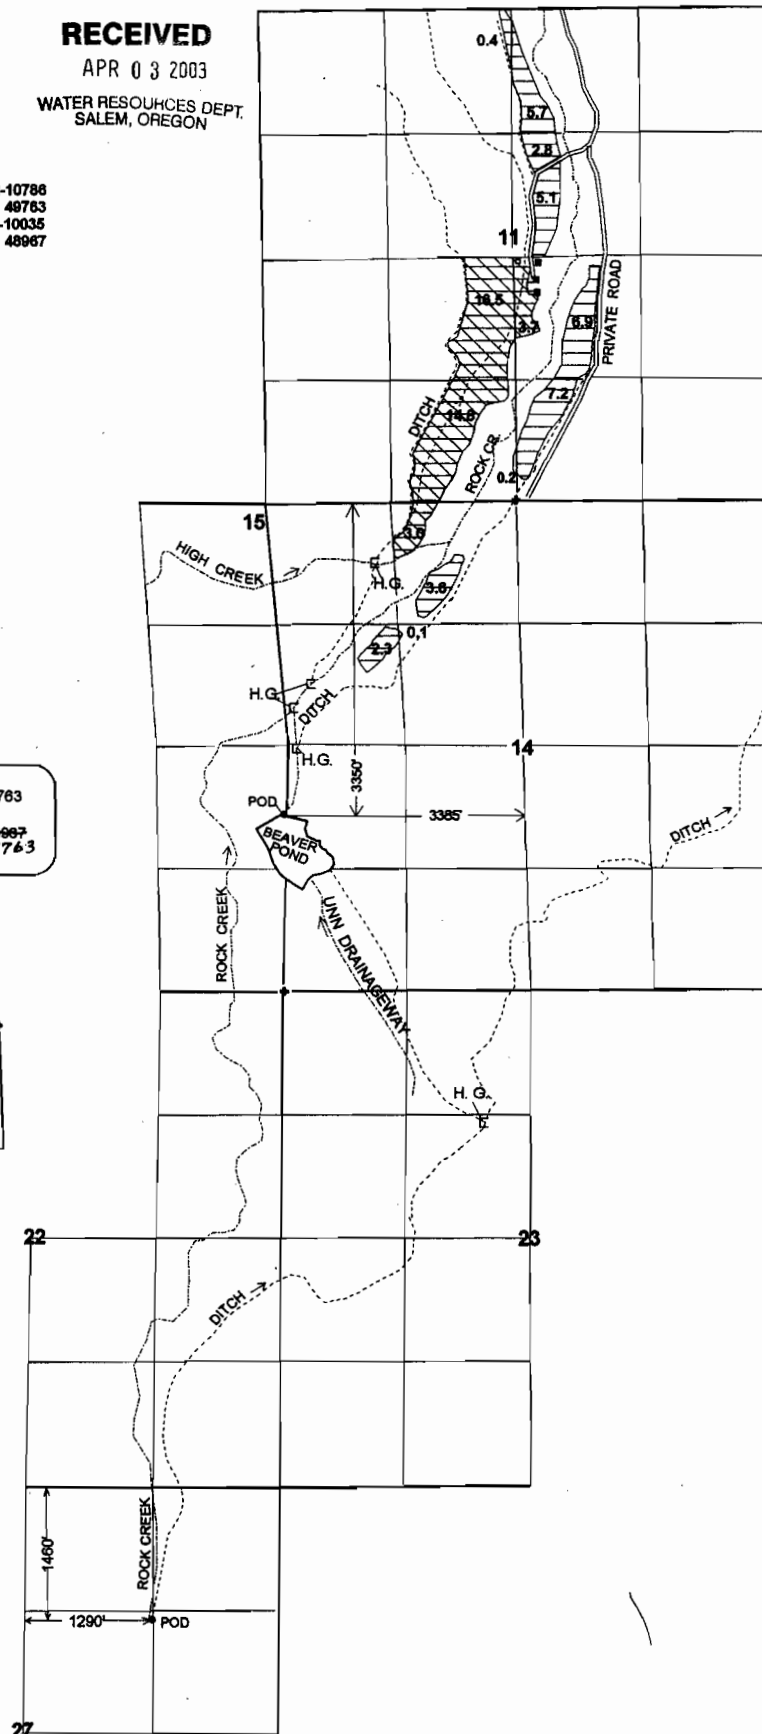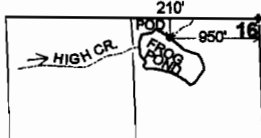

12/13/06 LHN