

TOWNSHIP 13 SOUTH, RANGE 24 EAST, W.M.

RECEIVED

APR 03 2003

WATER RESOURCES DEPT.
SALEM, OREGON

FINAL PROOF SURVEY UNDER

Application No. R-68815 Permit No. R-10786
68816 49763
R-68200 R-10035
68201 48967

IN THE NAMES OF
CLINTON O. HARRIS
AND
FLORA H. HARRIS
OF
ANTONE RANCH



Surveyed: July 17, 2002 by: J. Miller



1" = 1320'

-  IRRIGATION UNDER P #49763
AND P #48967
-  IRRIGATION UNDER P #48967
49763

POD - FROG POND RESERVOIR

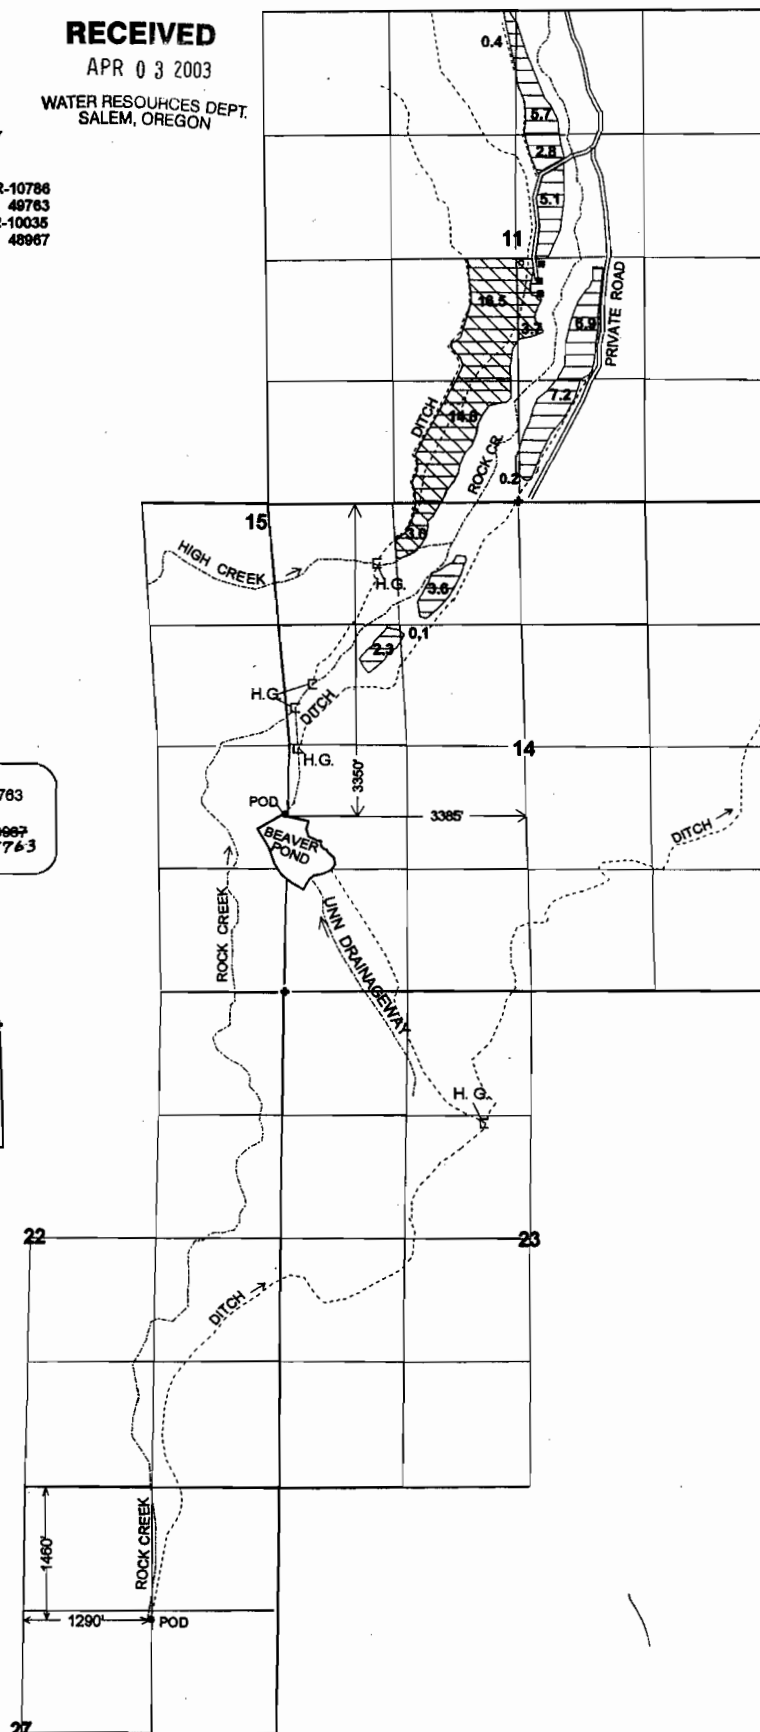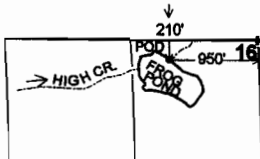

12/13/06 LNN