


T. 1 N., R. 1 W., W.M.

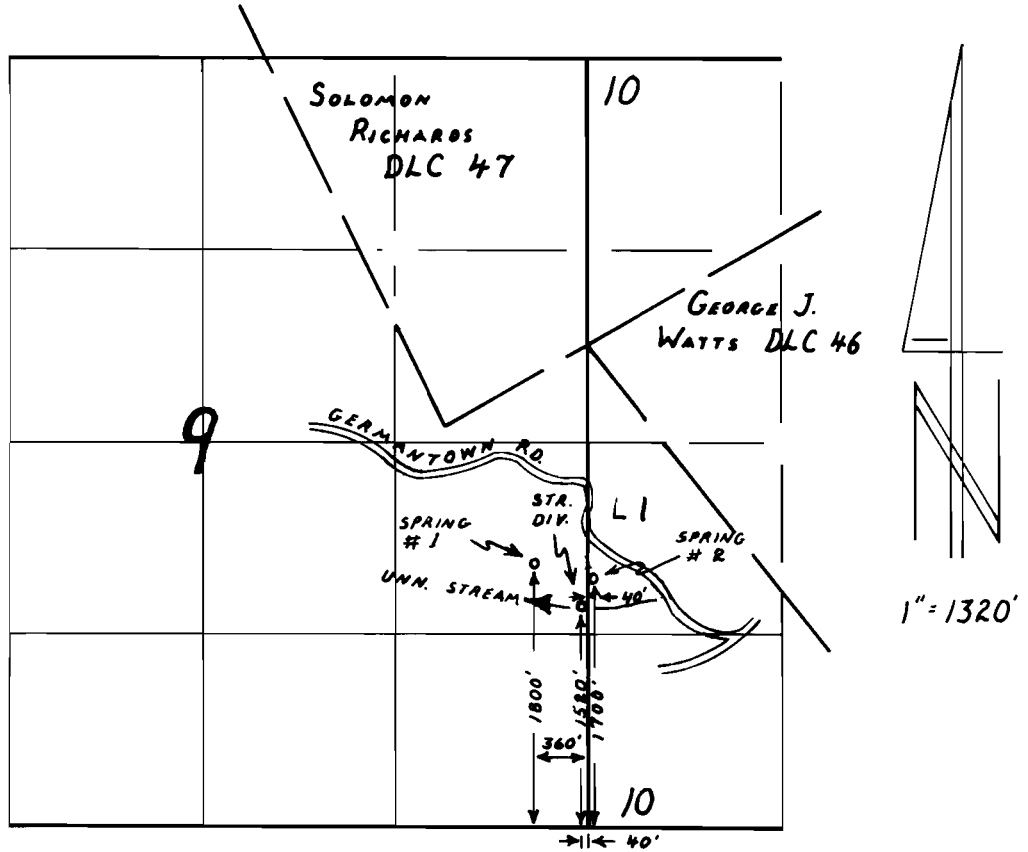

FINAL PROOF SURVEY

UNDER

Application No. 54578 Permit No. 41182

IN NAME OF

James A. Bullock

Surveyed July 27, 1993, by R.W. Klassen