


# T. 10 S., R 20 E., W. M.

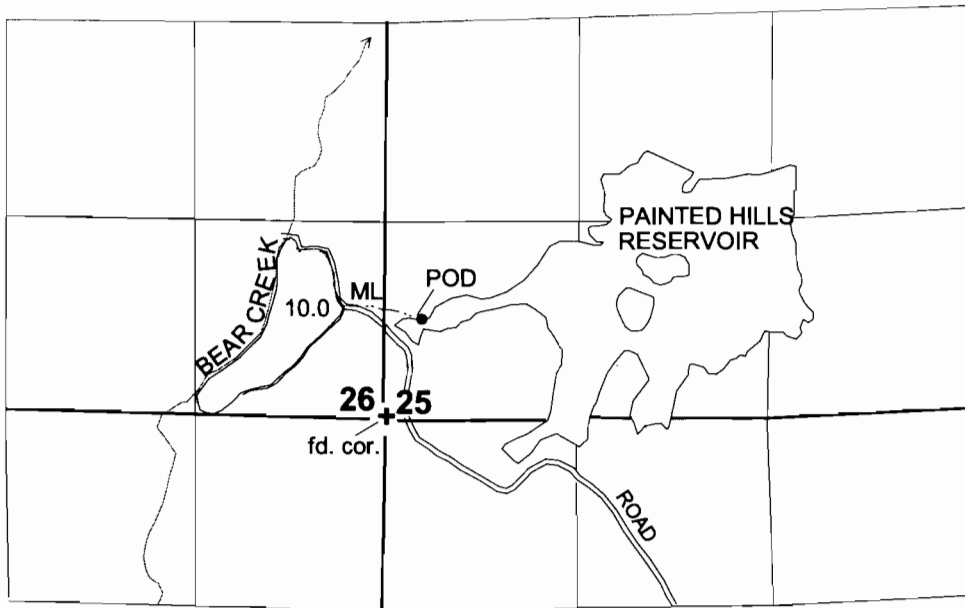

POD - 682 FEET NORTH AND 250 FEET EAST FROM THE SOUTHWEST CORNER OF SECTION 25.

## FINAL PROOF SURVEY UNDER

Application 57162 Permit 43143

IN THE NAME OF

E. C. NORTON, JR.

Surveyed 5-17-2000, By J. Miller



1" = 1320'