

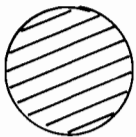


# T. 1 N., R. 20 & 21 E., W.M.

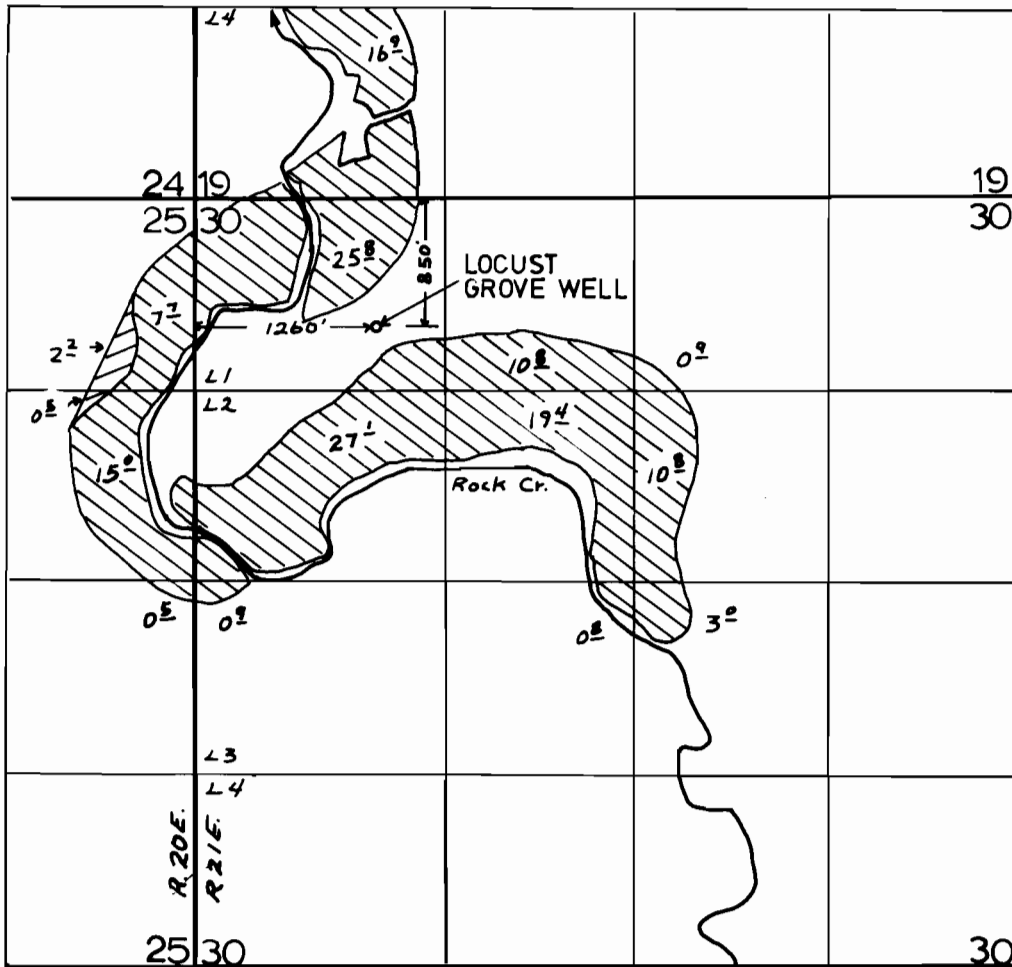

PRIMARY

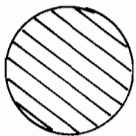

SUPPLEMENTAL


## FINAL PROOF SURVEY

UNDER

Application No. G-8764 Permit No. G-8353  
IN NAME OF

A. DAVID CHILDS AND PEGGY S. CHILDS

Surveyed MAY 18, 1994, by J. MILLER

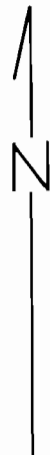

1" = 1320'