


T. 6 S., R 21 E., W.M.

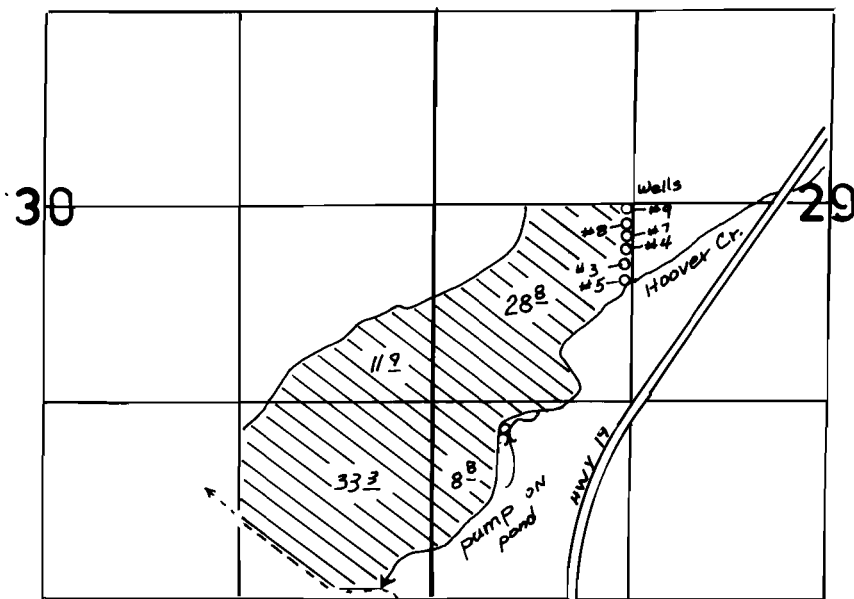

WELL 3 - 2280' N. & 1310' E.
WELL 4 - 2390' N. & 1310' E.
WELL 5 - 2180' N. & 1310' E.
WELL 7 - 2480' N. & 1310' E.
WELL 8 - 2570' N. & 1310' E.
WELL 9 - 2630' N. & 1310' E.

} ALL FROM SW COR. SEC. 29.

1" = 1320'

**FINAL PROOF SURVEY
UNDER**

**Application No. G-7013. Permit No. G-6513.....
IN NAME OF**

.....MERHTON HOMER.....

Surveyed G-5..... 2000, by J. MILLER.....