


T. 3 S., R. 26 E., W.M.

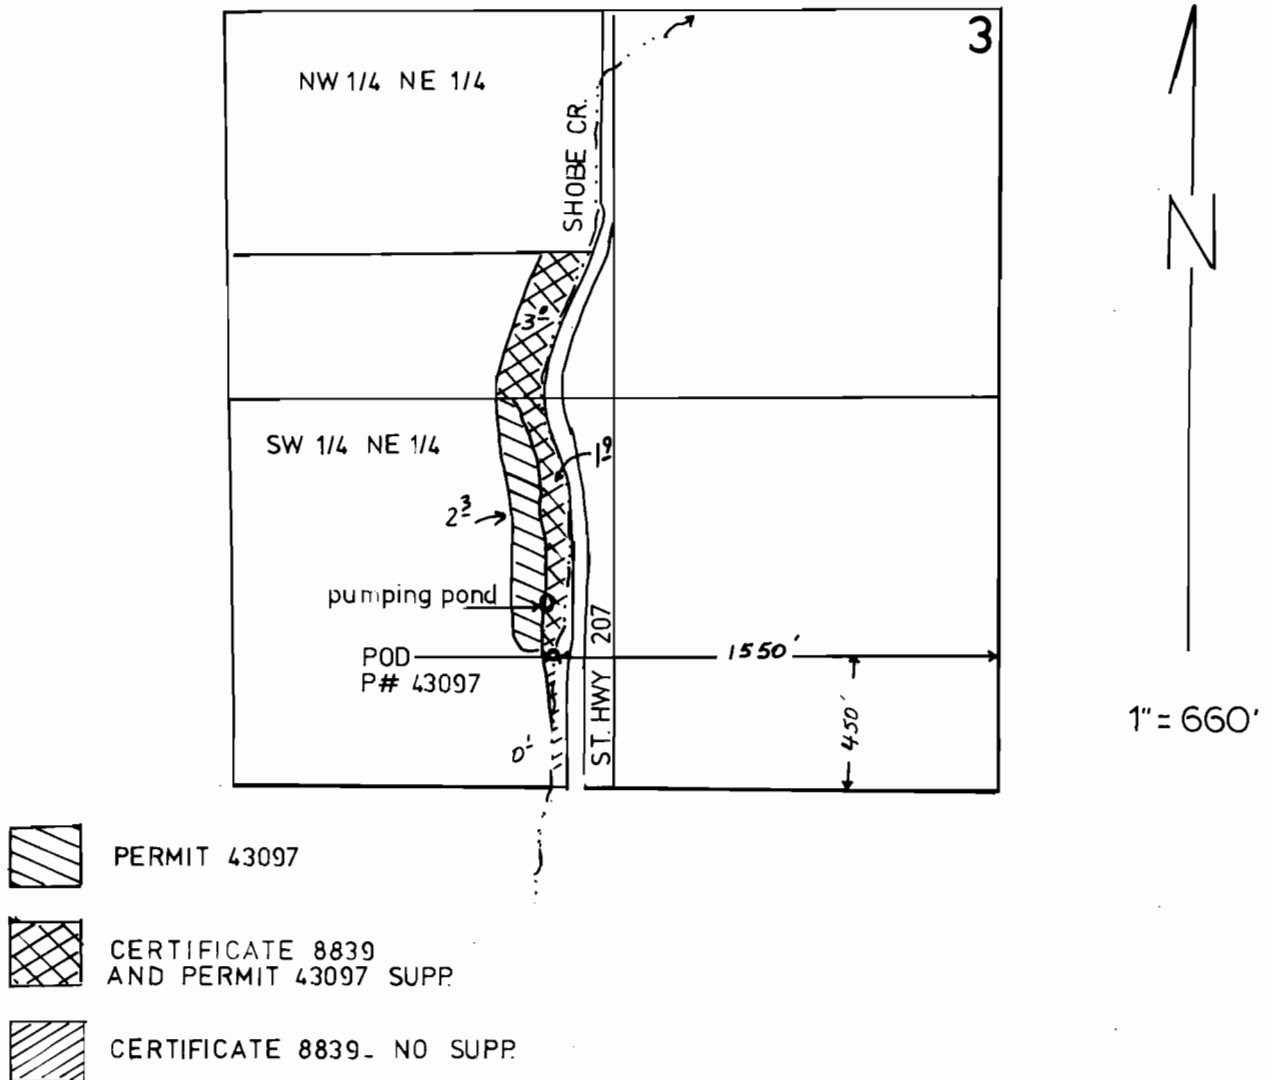

FINAL PROOF SURVEY

UNDER

Application No. 57281 Permit No. 43097
IN NAME OF

MARCEL JONES

Surveyed 10-14, 1993, by J. MILLER