


# T. 35 S., R. 12 E., W.M.

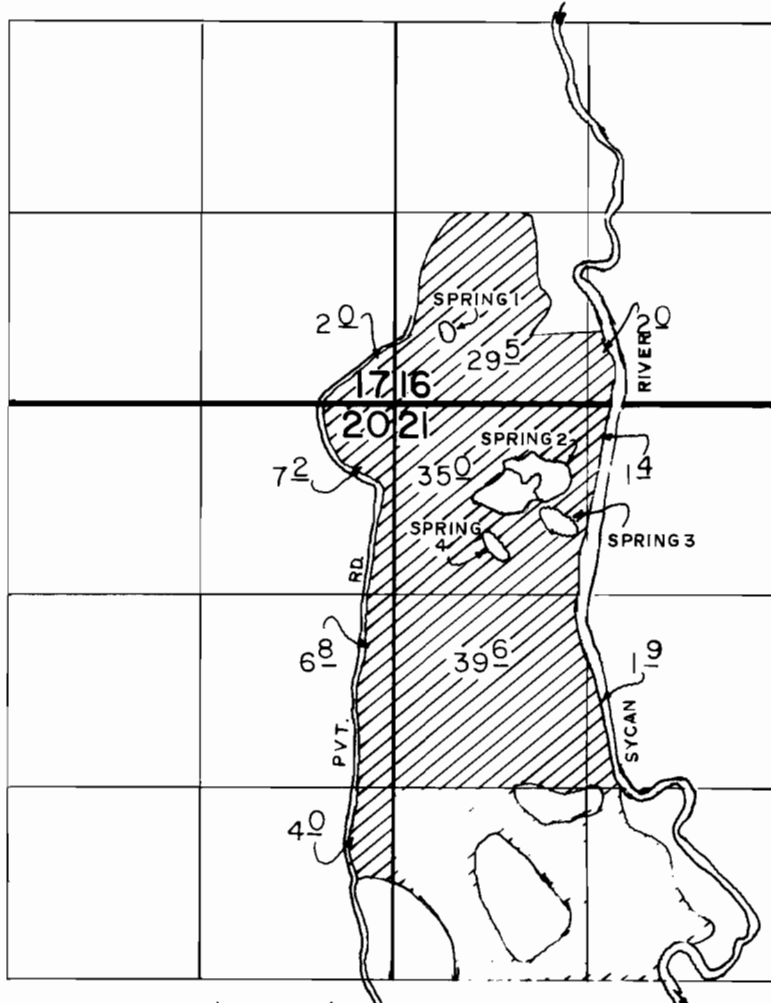

SPRING 1 LOC: 500' N & 380' E FROM SW COR. OF SEC 16.  
SPRING 2 LOC: 500' S & 1050' E FROM NW COR. OF SEC 21.  
SPRING 3 LOC: 800' S & 1130' E FROM NW COR. OF SEC 21.  
SPRING 4 LOC: 980' S & 700' E FROM NW COR. OF SEC 21.

SCALE: 1/320'

## FINAL PROOF SURVEY

UNDER

Application No. 54785 Permit No. 41106  
IN NAME OF

DEXTER, GEORGE & JERY

Surveyed JULY 26, 1994, by R.M.SUTTERFIELD