


T.27S., R.13W., W.M.

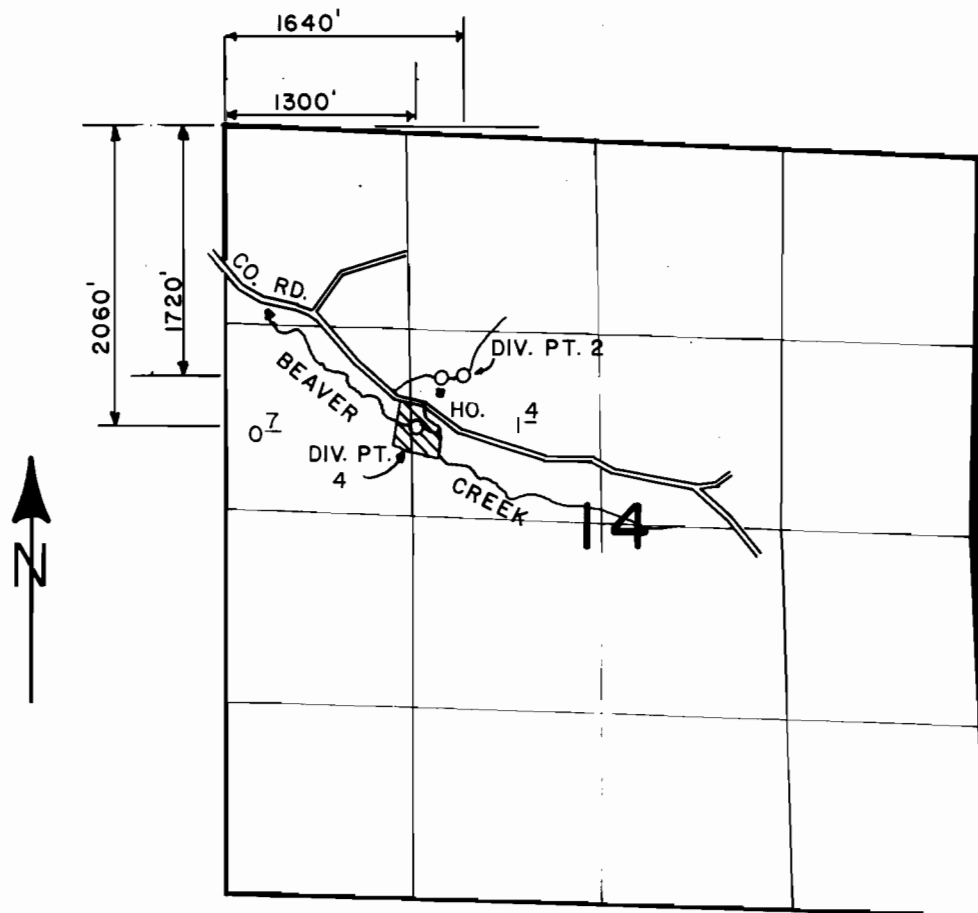

SCALE: 4" = 1 MILE

FINAL PROOF SURVEY
UNDER

Application No. 52945 Permit No. 40298
IN NAME OF

SAMUEL D. & DORIS HILLMAN

Surveyed OCT. 17, 1983, by L.E. CASHION
SEPT. 30, 1991 B. S. JAMES