


T.7N. R.2W. W.M.

Application No. 55540

Permit No. 42754

NOTE: HOUSES WEST OF
ROAD NOT INCLUDED
UNDER PERMIT
NO. 29797.

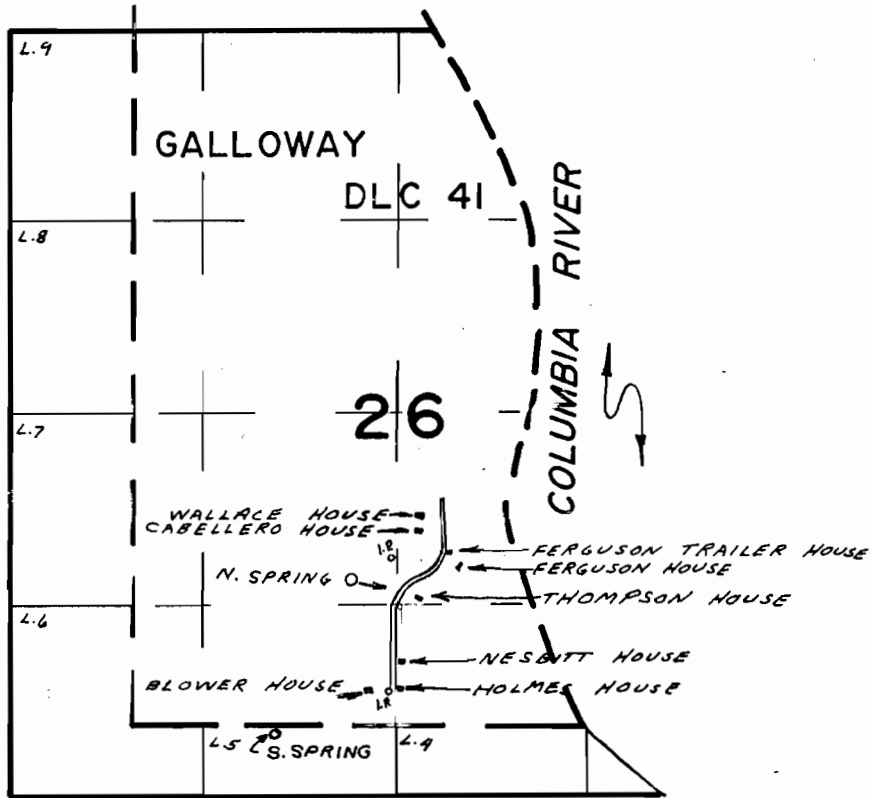

N. SPRING LOC. 1480'N & 310'W FROM S. 1/4 COR. SEC. 26
S. SPRING LOC. 466'N & 793'W " " " " " "

FINAL PROOF SURVEY
UNDER

Application No. 40003... Permit No. 29797...
IN NAME OF

.....**CHARLES M. KELLEY**.....

Surveyed JULY 1... 1976, by L.H. NUNN.....