


T. 2 N., R. 3 W., W.M.

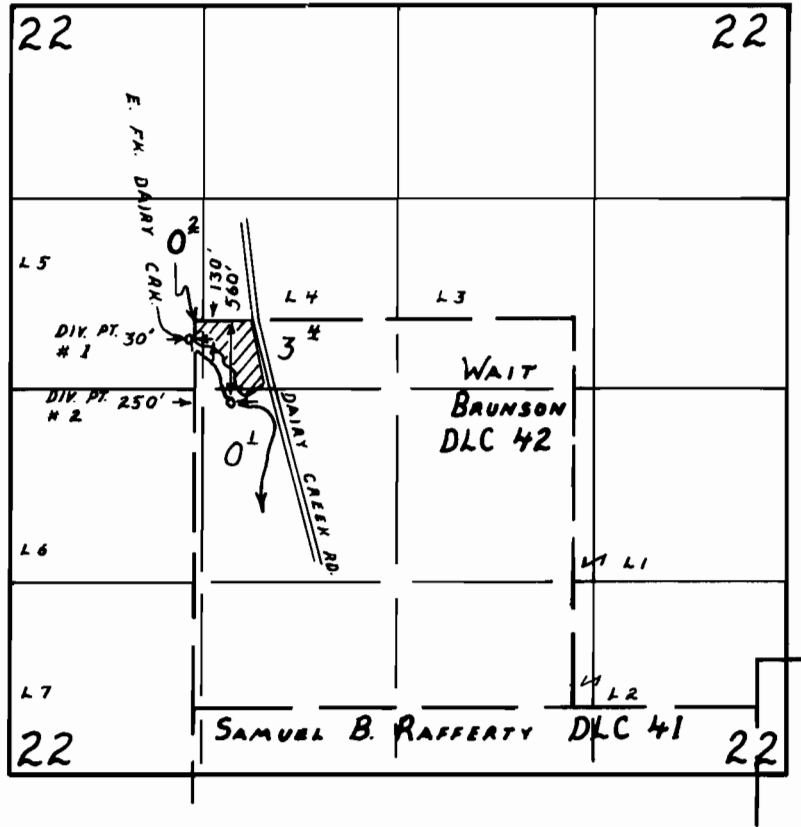

FINAL PROOF SURVEY

UNDER

Application No. 68357 Permit No. 49599
IN NAME OF

Dennis Johnson

Surveyed July 13, 1993, by R.W. Klassen