


T. IN. R. I W. W. M.

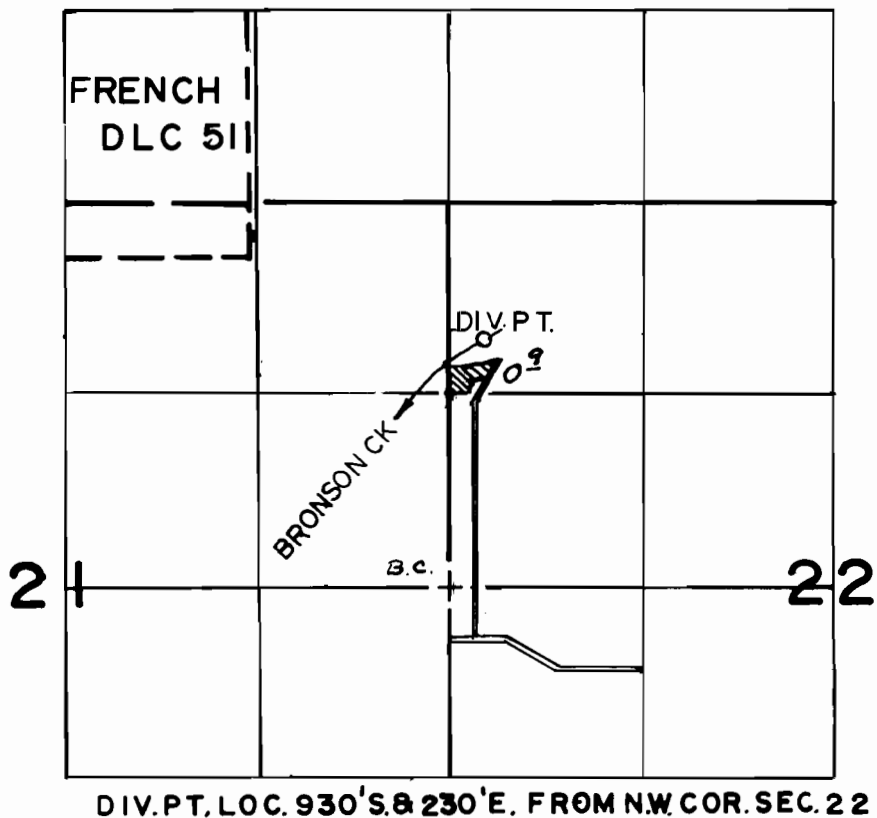

DIV. PT. LOC. 930' S. & 230' E. FROM N.W. COR. SEC. 22

FINAL PROOF SURVEY UNDER

Application No. 53435 Permit No. 39760.....
IN NAME OF

.....U. S. LARSEN.....
Surveyed JULY 8 93 by P. W. KLASSEN
NOV 8 1979, by R. G. MUCKEN.....

DF0 - ILL 270

RWK 12/93
REM