


T 23 S, R 32 1/2 E, WM

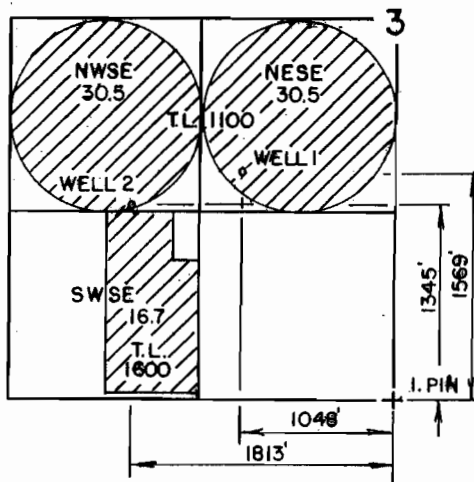

THE PURPOSE OF THIS MAP IS TO
IDENTIFY THE LOCATION OF THE
WATER RIGHT. IT IS NOT INTENDED
TO PROVIDE INFORMATION RELATIVE
TO THE LOCATION OF PROPERTY
OWNERSHIP.

RECEIVED
OCT 30 2006
WATER RESOURCES DEPT
SALEM, OREGON

RENEW 1-1-2007	FINAL PROOF SURVEY		
	UNDER APPLICATION G-8128 PERMIT G-7639		IN THE NAME OF HARRY T. & CECILIA MCCALL
	Scale: 4" = 1 MILE	Date: OCT. 2006	Job: 2206-Q6
	Dsn:	M.A. PALMER & SONS, INC. ENGINEERING & SURVEYING 711 Ponderosa Village • Box 61 Burns, Oregon 97720	Sht. No.
Drn: CHRIS	of 1		
Ckd:			