


# T. 8 and 9 S., R. 25 E., W.M.

RECEIVED  
MAR 31 1997  
WATER RESOURCES DEPT.  
SALEM, OREGON

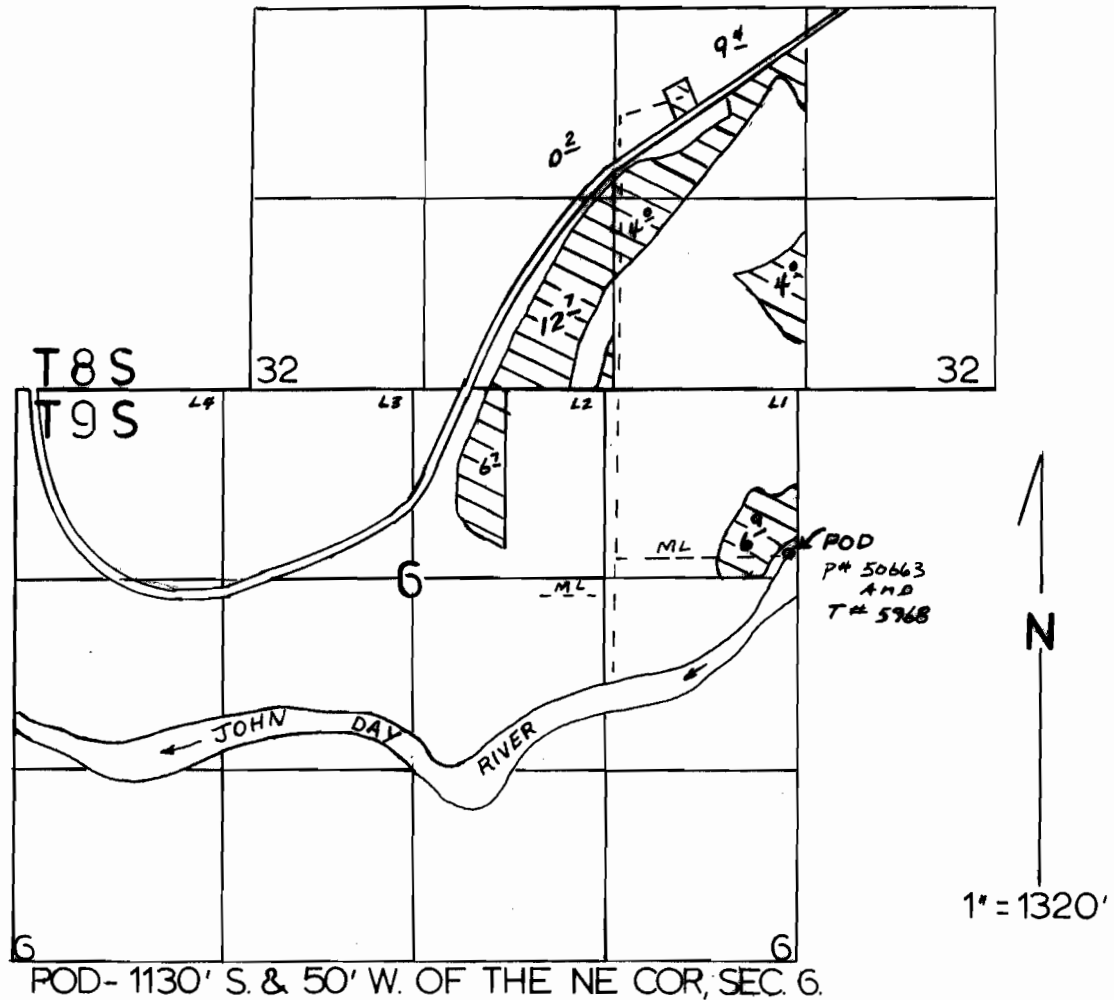

## FINAL PROOF SURVEY

UNDER  
Application No. 69170 Permit No. 50663 & POD TRAN. 5968  
IN NAME OF

ROBERT M. AND ELEANOR M. ORDWAY

Surveyed May 18, 1995, by L. Miller