


T. 10 & 11 S., R. 22 E., W.M.

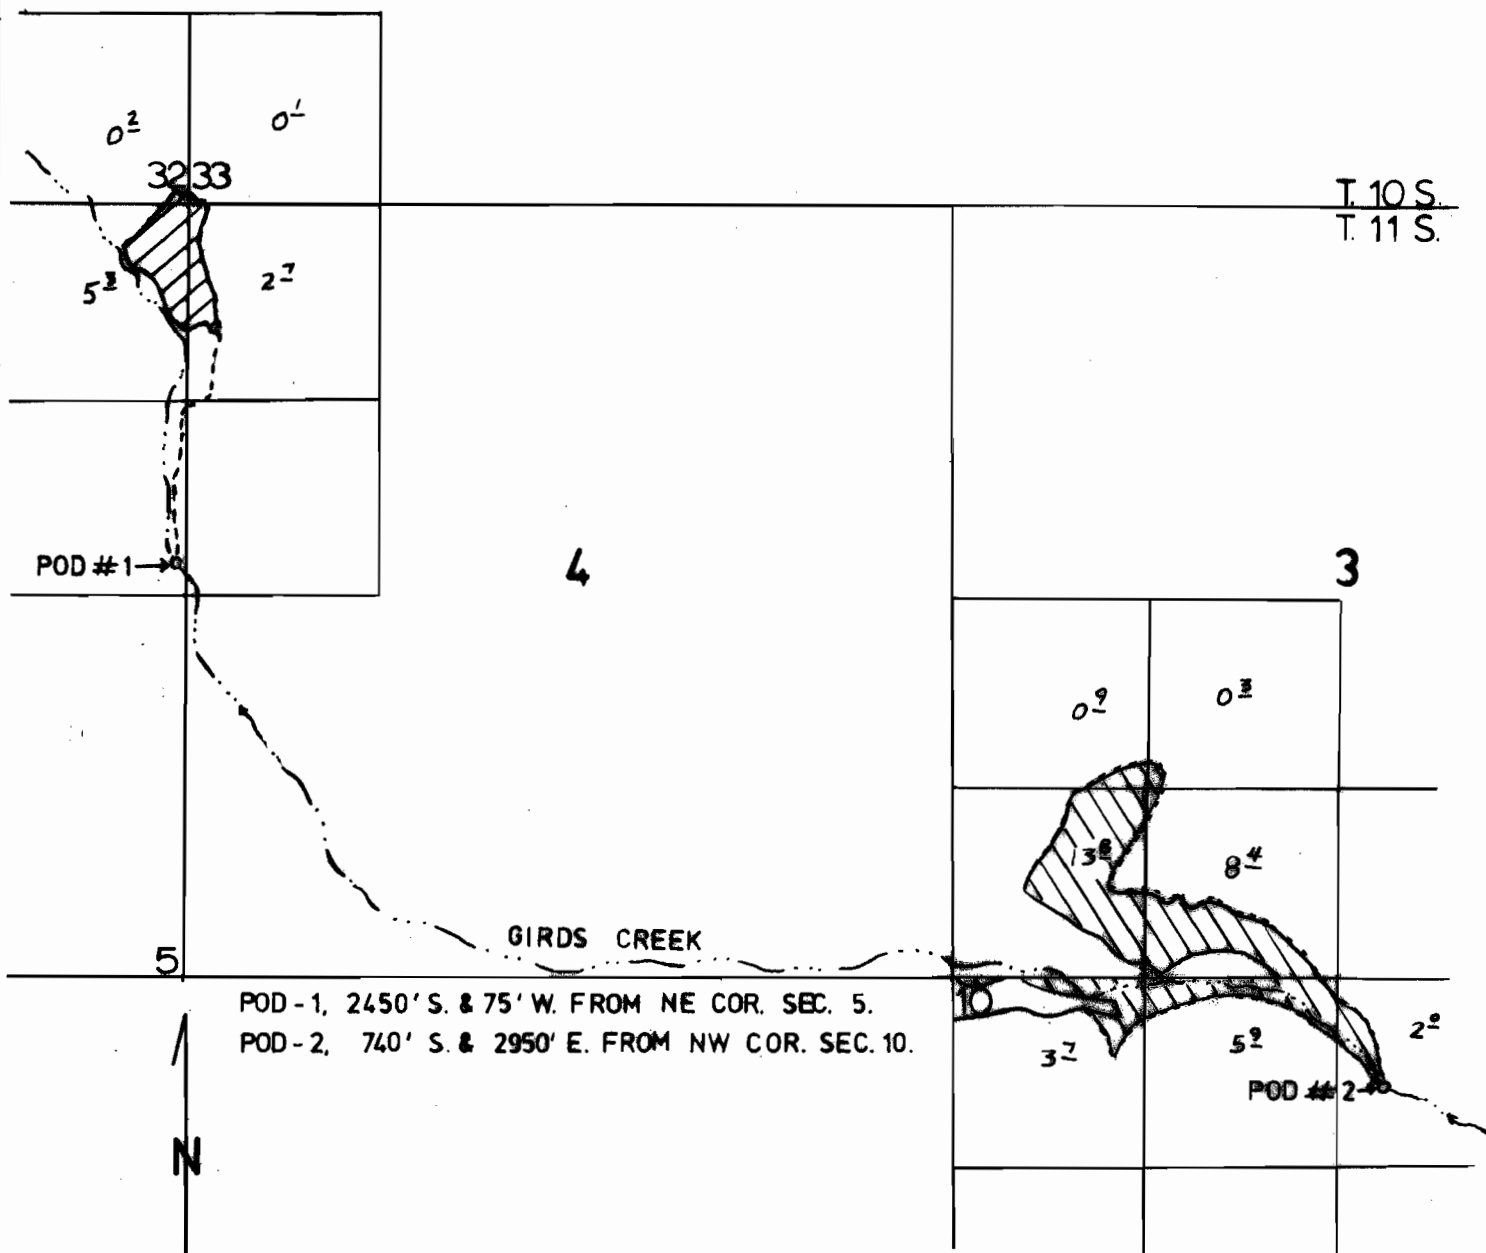

FINAL PROOF SURVEY UNDER

Application No. 64954 Permit No. 47600
IN NAME OF

ELMER J. AND AUDREY M. JACKSON

Surveyed 9-16, 1992, by J. MILLER

