


T. 8S., R. 19E., W.M.

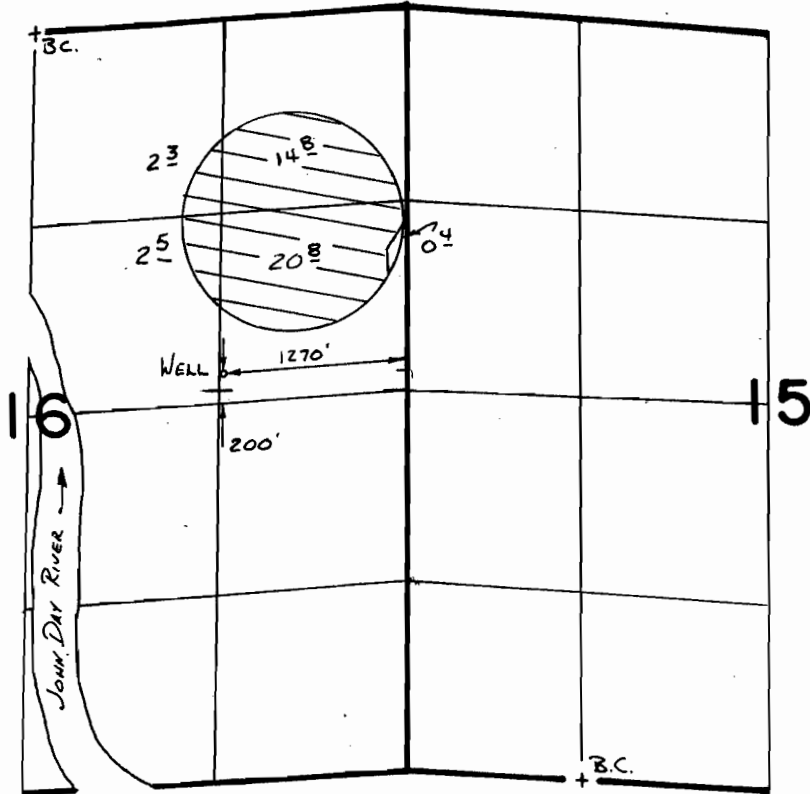

SCALE 1" = 1320'

FINAL PROOF SURVEY
UNDER

Application No. **G:10957** Permit No. **G:10642**
IN NAME OF

BARBARA Y. & WILLIAM J. BOWERMAN

Surveyed 5-12 1987, by V. G. Church