


T. 8 S., R. 19 E., W.M.

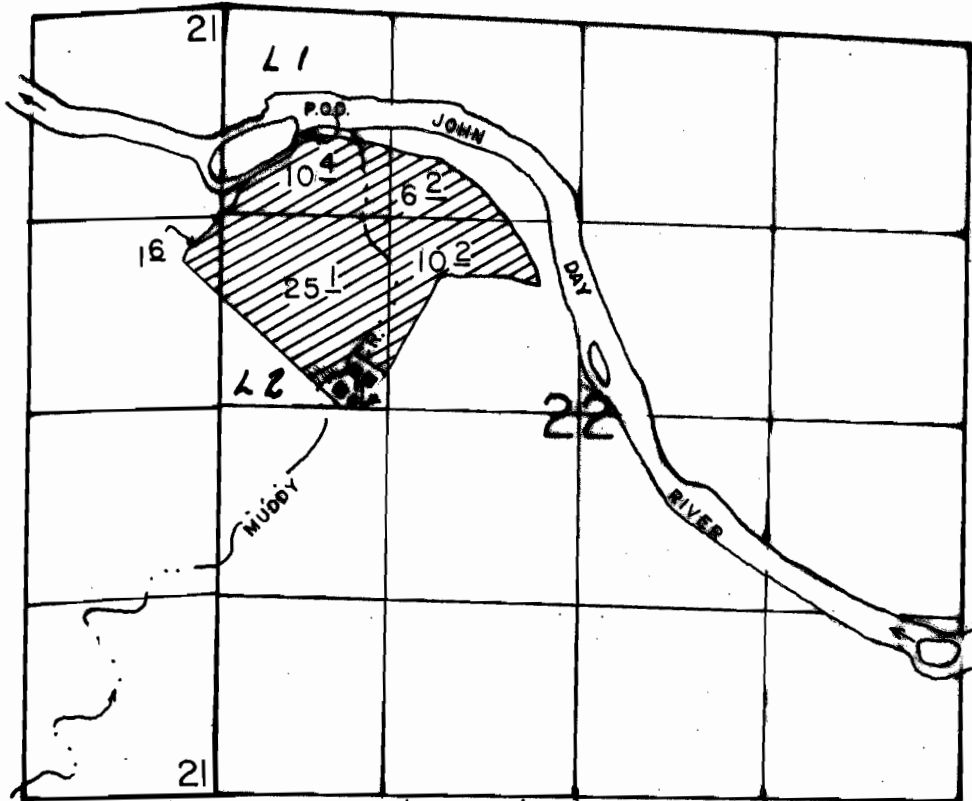

P.O.D. LOC: 850' S & 600' E FROM NW COR. OF SEC 22.

SCALE: 1" = 1320'

MAR 29 1995
WATER RESOURCES DEPT
SALEM, OREGON

FINAL PROOF SURVEY

UNDER

53 E. A.

Application No. 55877 Permit No. 41912
IN NAME OF

CONNECTICUT GENERAL LIFE INSURANCE CO.

Surveyed MARCH 20, 1995, by R.M. SUTTERFIELD