


T. 8 S., R. 25 E., W. M.

RECEIVED

MAY - 2 1997

WATER RESOURCES DEPT.
SALEM, OREGON

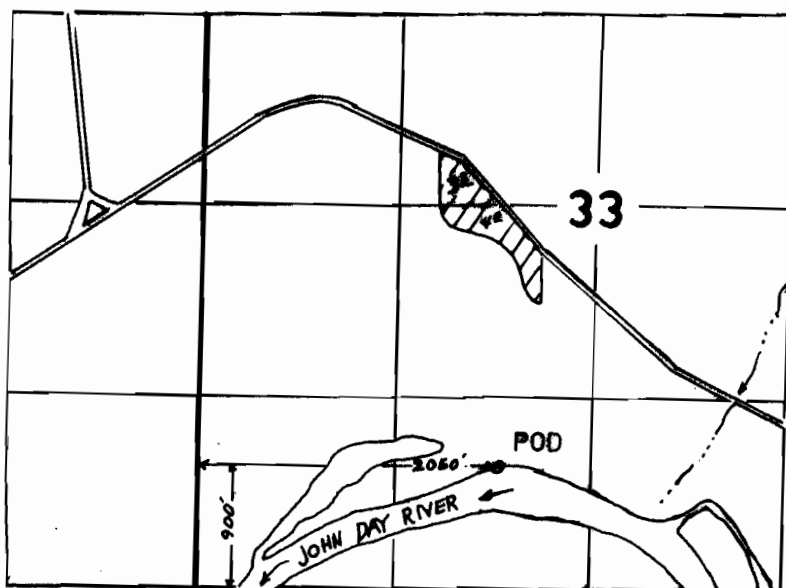

1" = 1320'

**FINAL PROOF SURVEY
UNDER**

Application No. ~~6440~~..... Permit No. 47552.....
IN NAME OF

JACK B. AND DOROTHY B. GAYER.....

Surveyed JUNE 6... 1995., by J. MILLER.....