


T. 1 N., R. 20 E., W.M.

ξ
T 1 N, R 21 E, W.M.

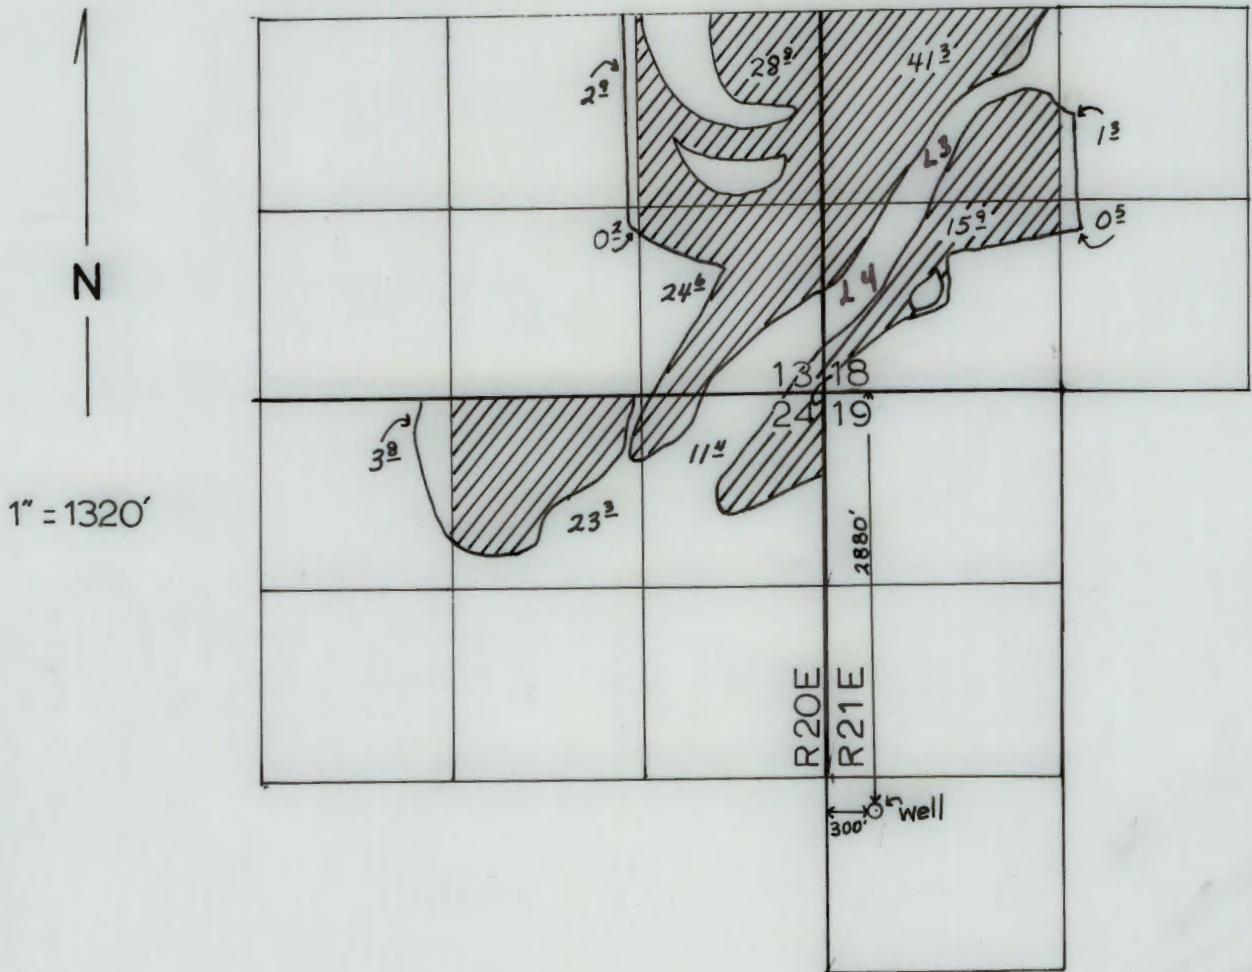

FINAL PROOF SURVEY

UNDER

Application No. G-10117 Permit No. G 9802
IN NAME OF

TIM R. MARICK

Surveyed 2-6, 1991, by K.KEMP


12/14/06 JWG

Drafted 3-16-93 J.M. 41021-279-258L

T. 1 N., R. 20 E., W.M.

T. 1 N., R. 20 E., W.M.

T. 1 N., R. 21 E., W.M.

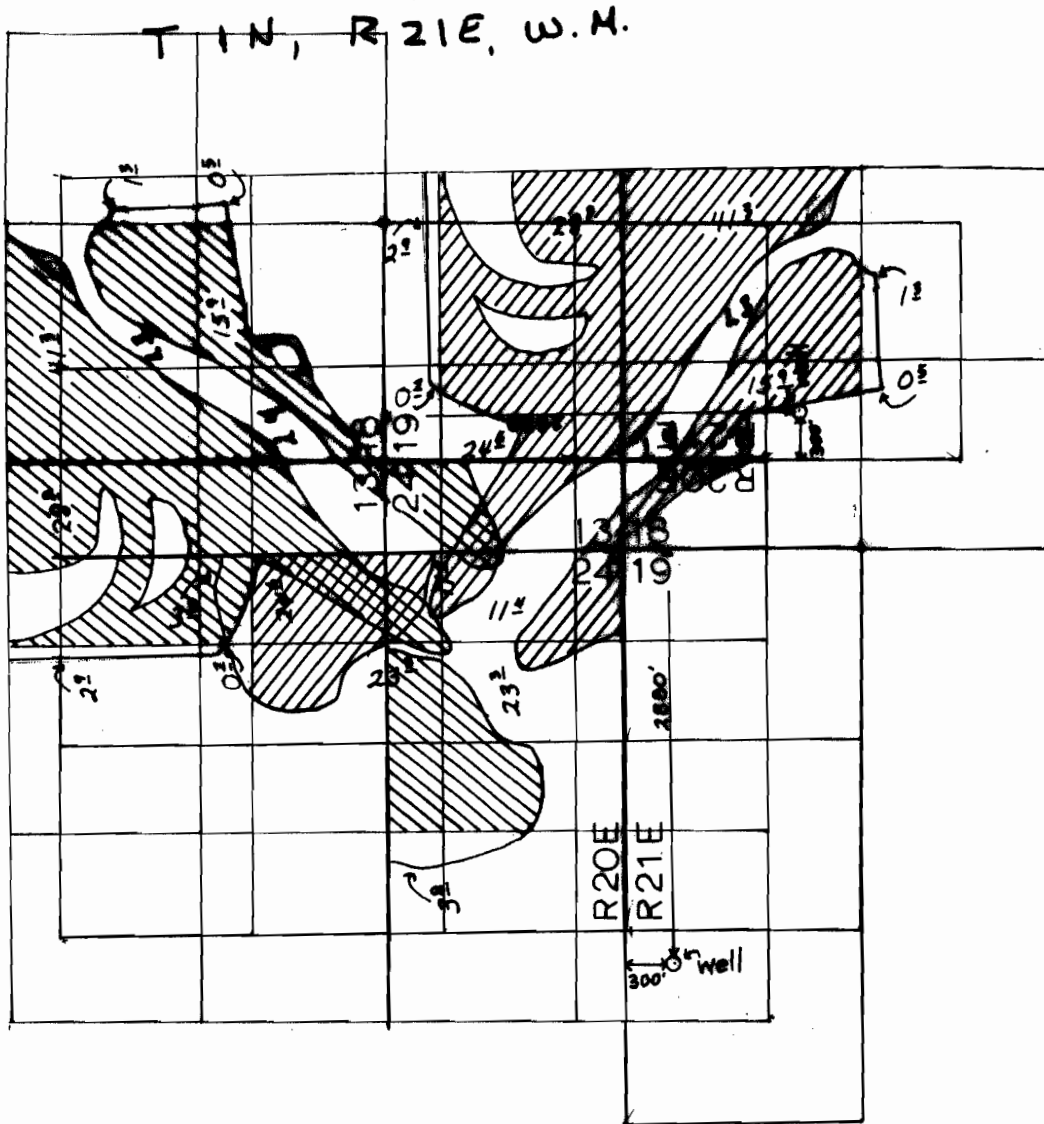

FINAL PROOF SURVEY

UNDER

1" = 1320'

FINAL PROOF SURVEY

UNDER

Application No. G-10117 Permit No. G 9802
IN NAME OF

TIM R. MARICK

Surveyed 2-6, 1991, by K.KEMP

12/14/06 JWS
Drafted 3-16-93 J.M. 41021-279-250L