


T. 2 S., R. 24 E., W.M.

RECEIVED

SEP - 4 1997

WATER RESOURCES DEPT.
SALEM, OREGON

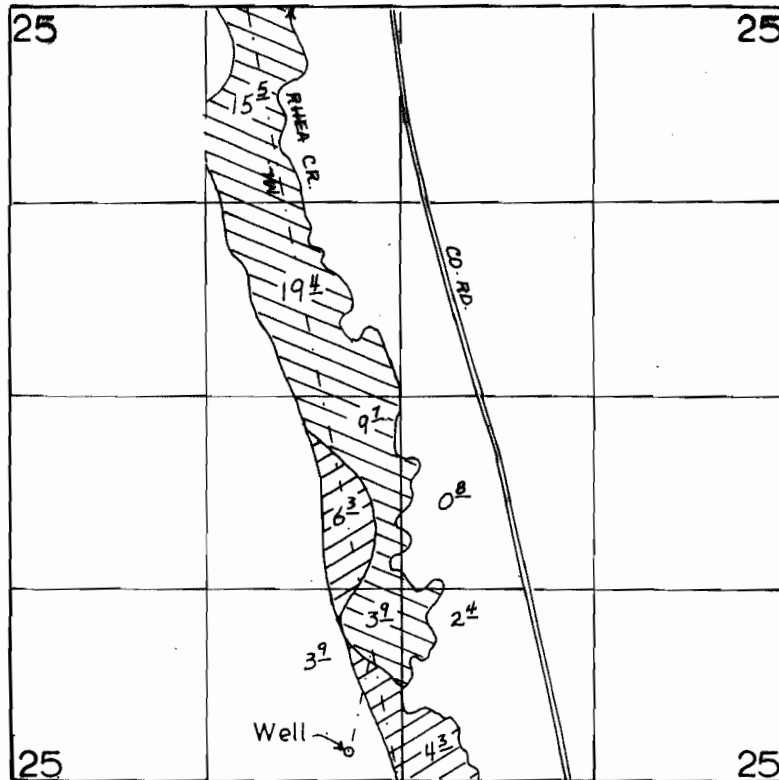

WELL - 330' N. & 540' W. FROM S 1/4 COR. SEC. 25.



PRIMARY IRR.



SUPPLEMENTAL IRR.



1" = 1320'

FINAL PROOF SURVEY
UNDER

Application No. G-6789 Permit No. G-6300
IN NAME OF

QUARTER CIRCLE V. RANCHES, INC.

Surveyed May 21, 1996, by J. Miller

12/14/06 JWG