


T. 25S., R. 12W., W.M.

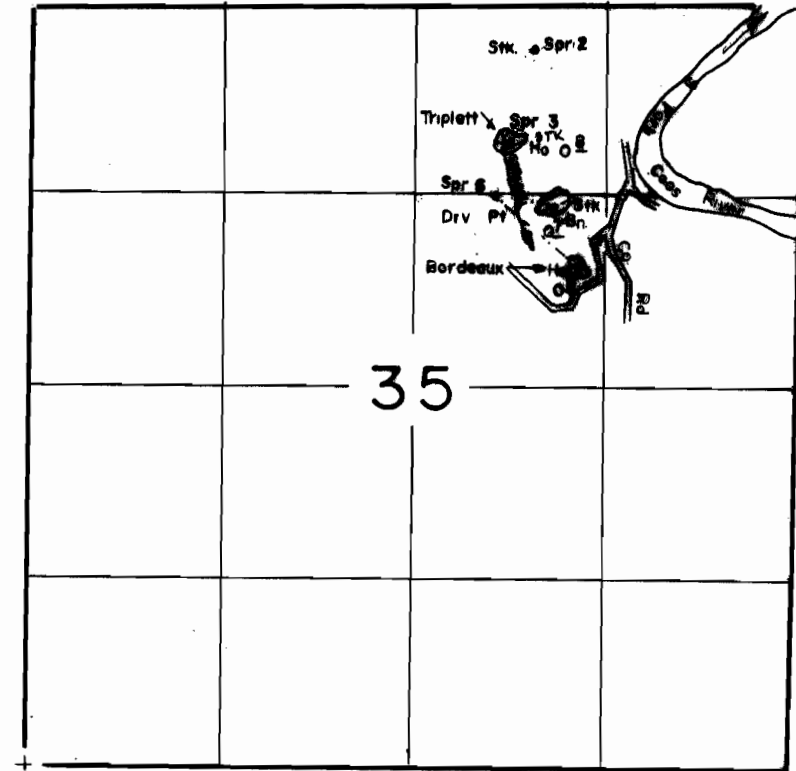

FC  
Springs Located, 2-300'S & 800'E, 3-870'S & 600'E, 6-1300'S & 550'E, Unn Stream 1350'S & 700'E, All From N¼ Corner Sec 35

SCALE: 1" = 1320'

**FINAL PROOF SURVEY**  
UNDER

Application No. 58012.... Permit No. 43751.....

IN NAME OF  
**JOSEPH L. TRIPLETT**  
...WILLIAM G. & SHARON J. BORDEAUX.

Surveyed JULY..11..... 19.8.9., by J.M...SCHMORDE...