
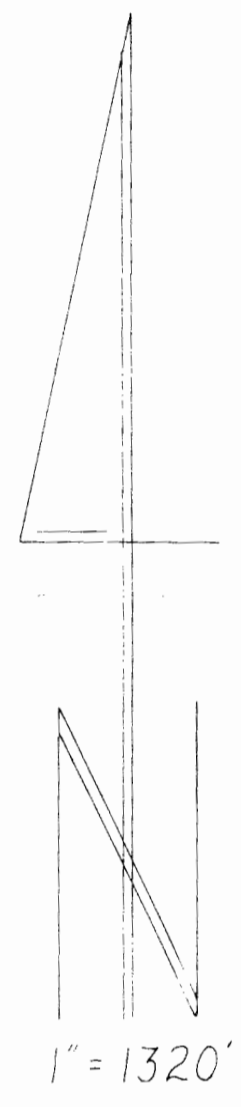
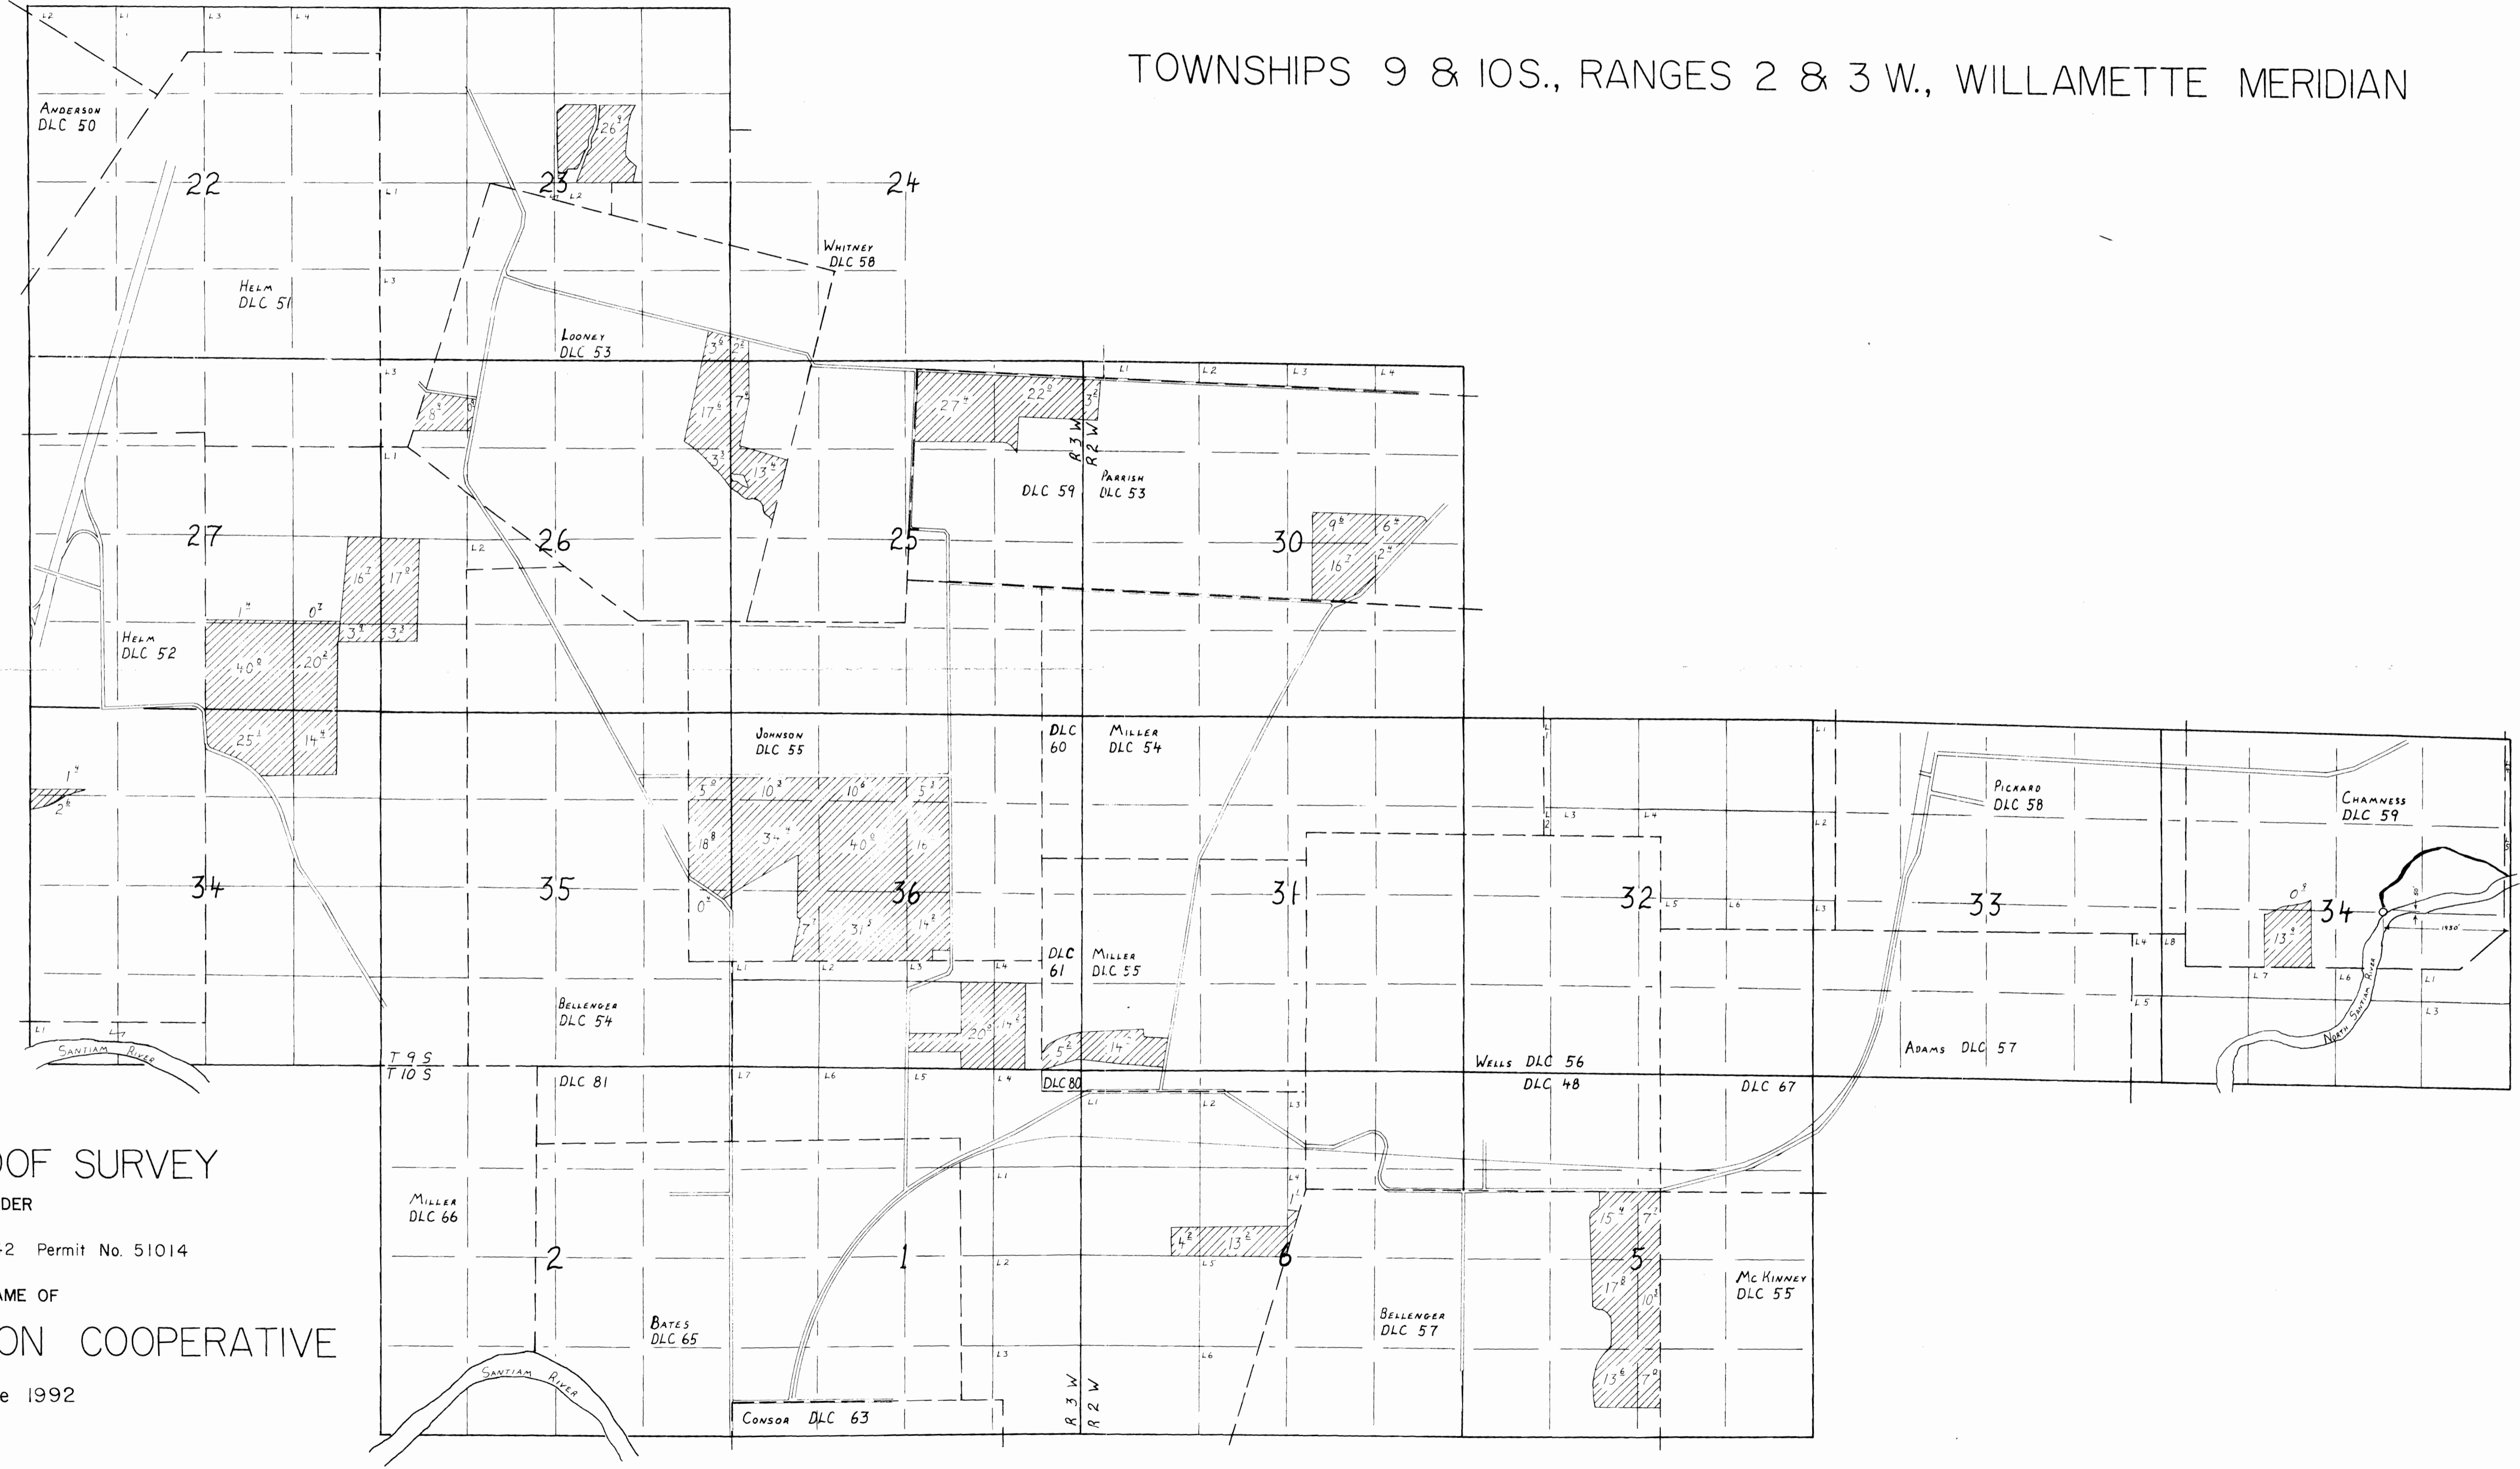


TOWNSHIPS 9 & 10S., RANGES 2 & 3 W., WILLAMETTE MERIDIAN

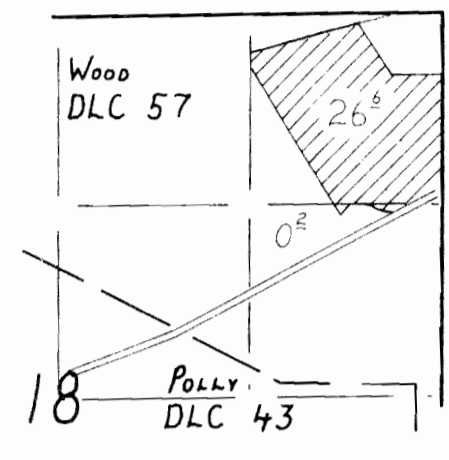

FINAL PROOF SURVEY

UNDER

Application No. 67342 Permit No. 51014

IN NAME OF

SIDNEY IRRIGATION COOPERATIVE

Surveyed June 1992