


T. 2 S., R. 5 E., W.M.

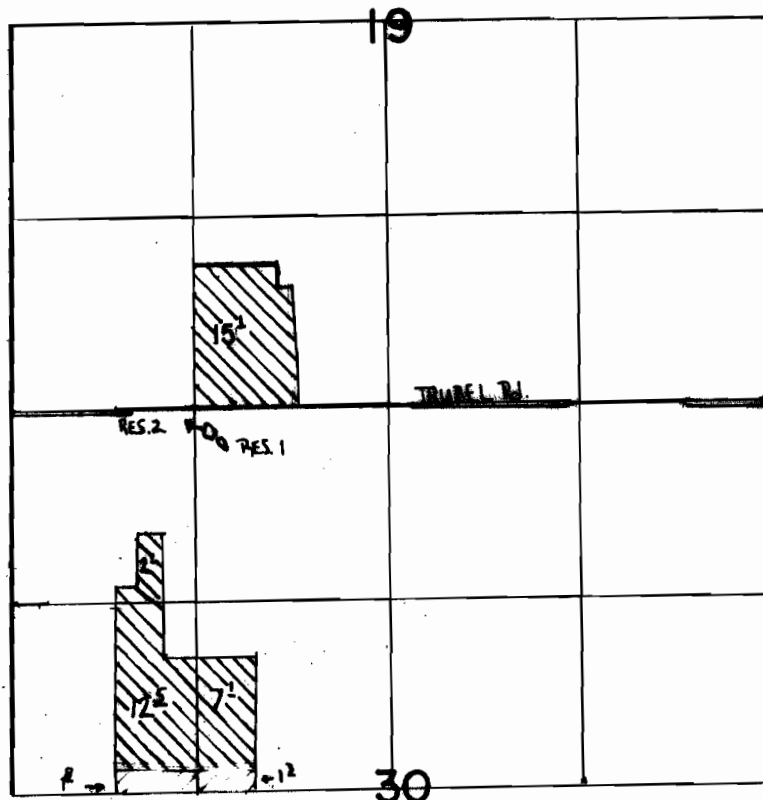

1"=1320'

RES. 1- 220' S. & 1500' E.

RES 2- 100' S & 1340' E, BOTH FROM NW COR. SEC. 30

☒ Supplemental

FINAL PROOF SURVEY

UNDER

Application No. A-68992 Permit No. A-10917
IN NAME OF

FRED E. WICKERSHAM

Surveyed AUGUST 21, 1992, by R.W. KLASSEN

12/13/06 JWG

KC Feb 1993