


T. 2 N., R. 1 W., W.M.

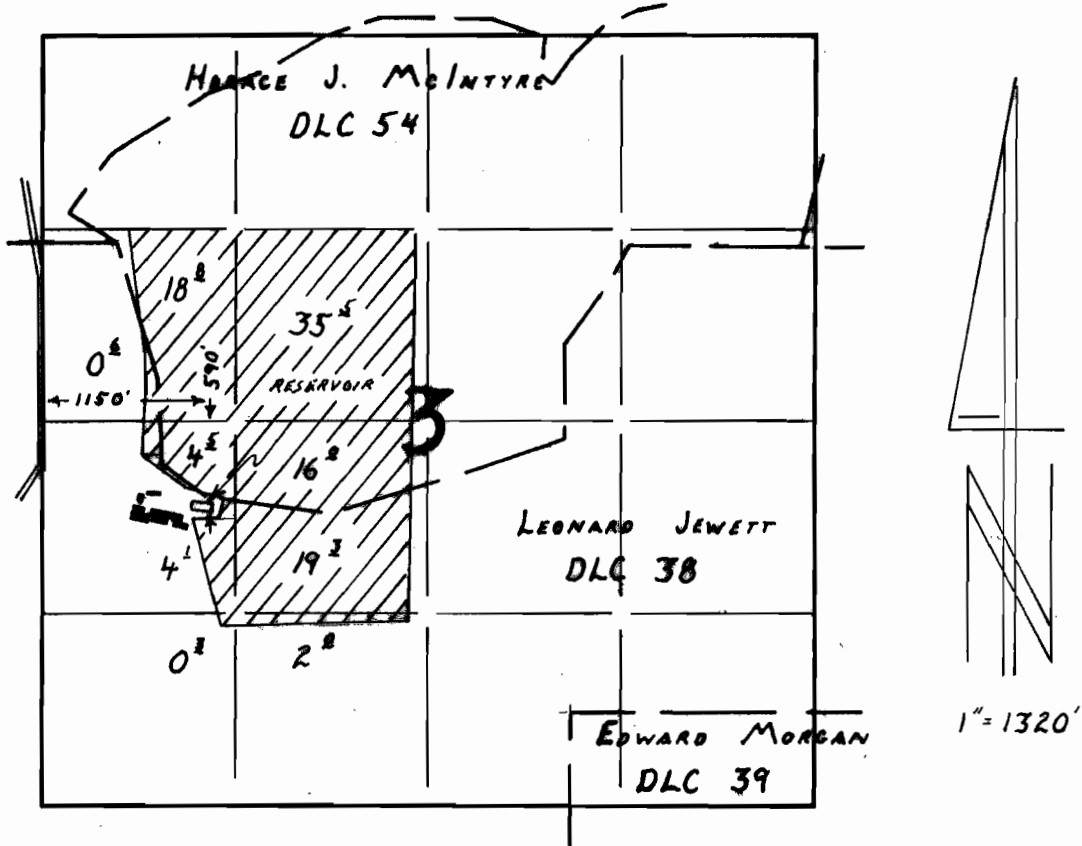

FINAL PROOF SURVEY

UNDER

Application No. R-63771, 64326 Permit No. R-8656, 47539
IN NAME OF

Richard W. Vetsch

Surveyed July 8, 1993, by R.W. Klassen