
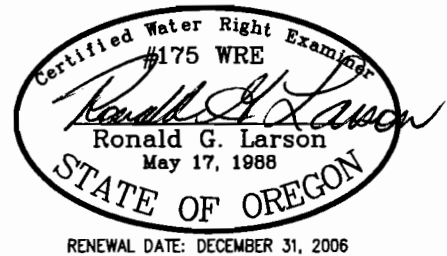
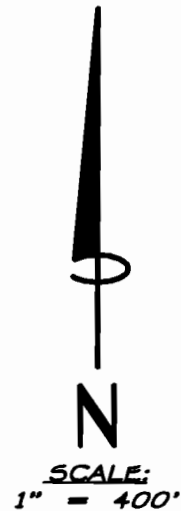


WATER RIGHT TRANSFER MAP
IN THE NAME OF: SEASIDE RETREAT, LLC
SW 1/4 SECTION 7, T4N, R10W, WM
CLATSOP COUNTY
MAY 12, 2005

RECEIVED

JUN 08 2005
WATER RESOURCES DEPT
SALEM, OREGON

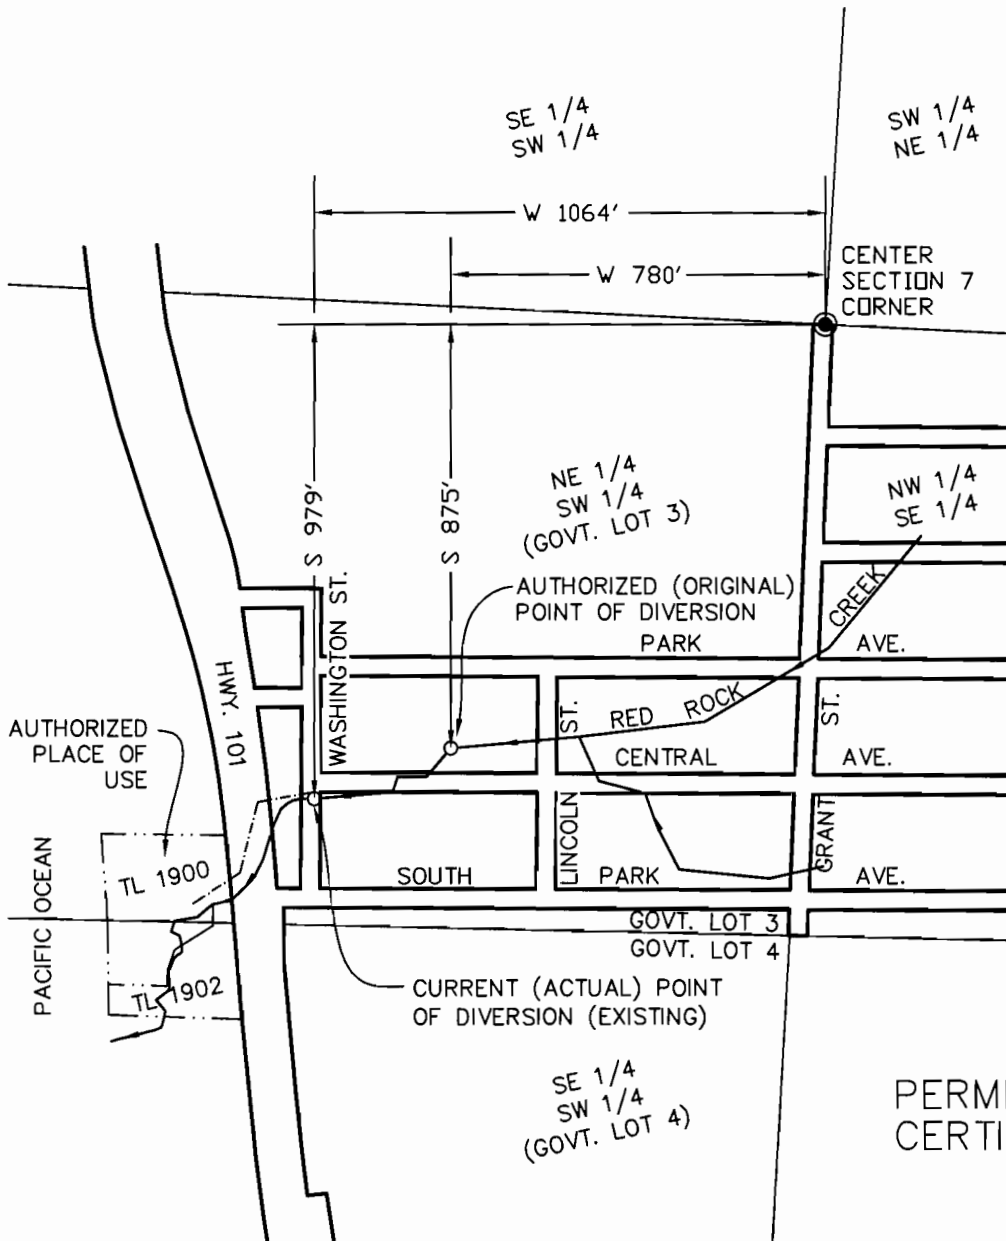

PERMIT NO. 17178
CERTIFICATE NO. 21645

THE PURPOSE OF THIS MAP IS TO IDENTIFY THE LOCATION OF THE WATER RIGHT. IT IS NOT INTENDED TO PROVIDE INFORMATION RELATIVE TO THE LOCATION OF PROPERTY OWNERSHIP BOUNDARY LINES.

1-9947

FILE: G028253-02-02.DWG

HLB & ASSOCIATES, INC.
SURVEYING • ENGINEERING • PLANNING

160 LANEDA AVE. MANZANITA, OR 97130 (503) 368-5394 FAX: (503) 368-5847	4253A HWY 101 N. GEARHART, OR 97138 (503) 738-3425 FAX: (503) 738-7455
---	---